


**HAROLD H. KOLB**  
REGISTERED PROFESSIONAL LAND SURVEYOR  
LAKE GENEVA, WISCONSIN

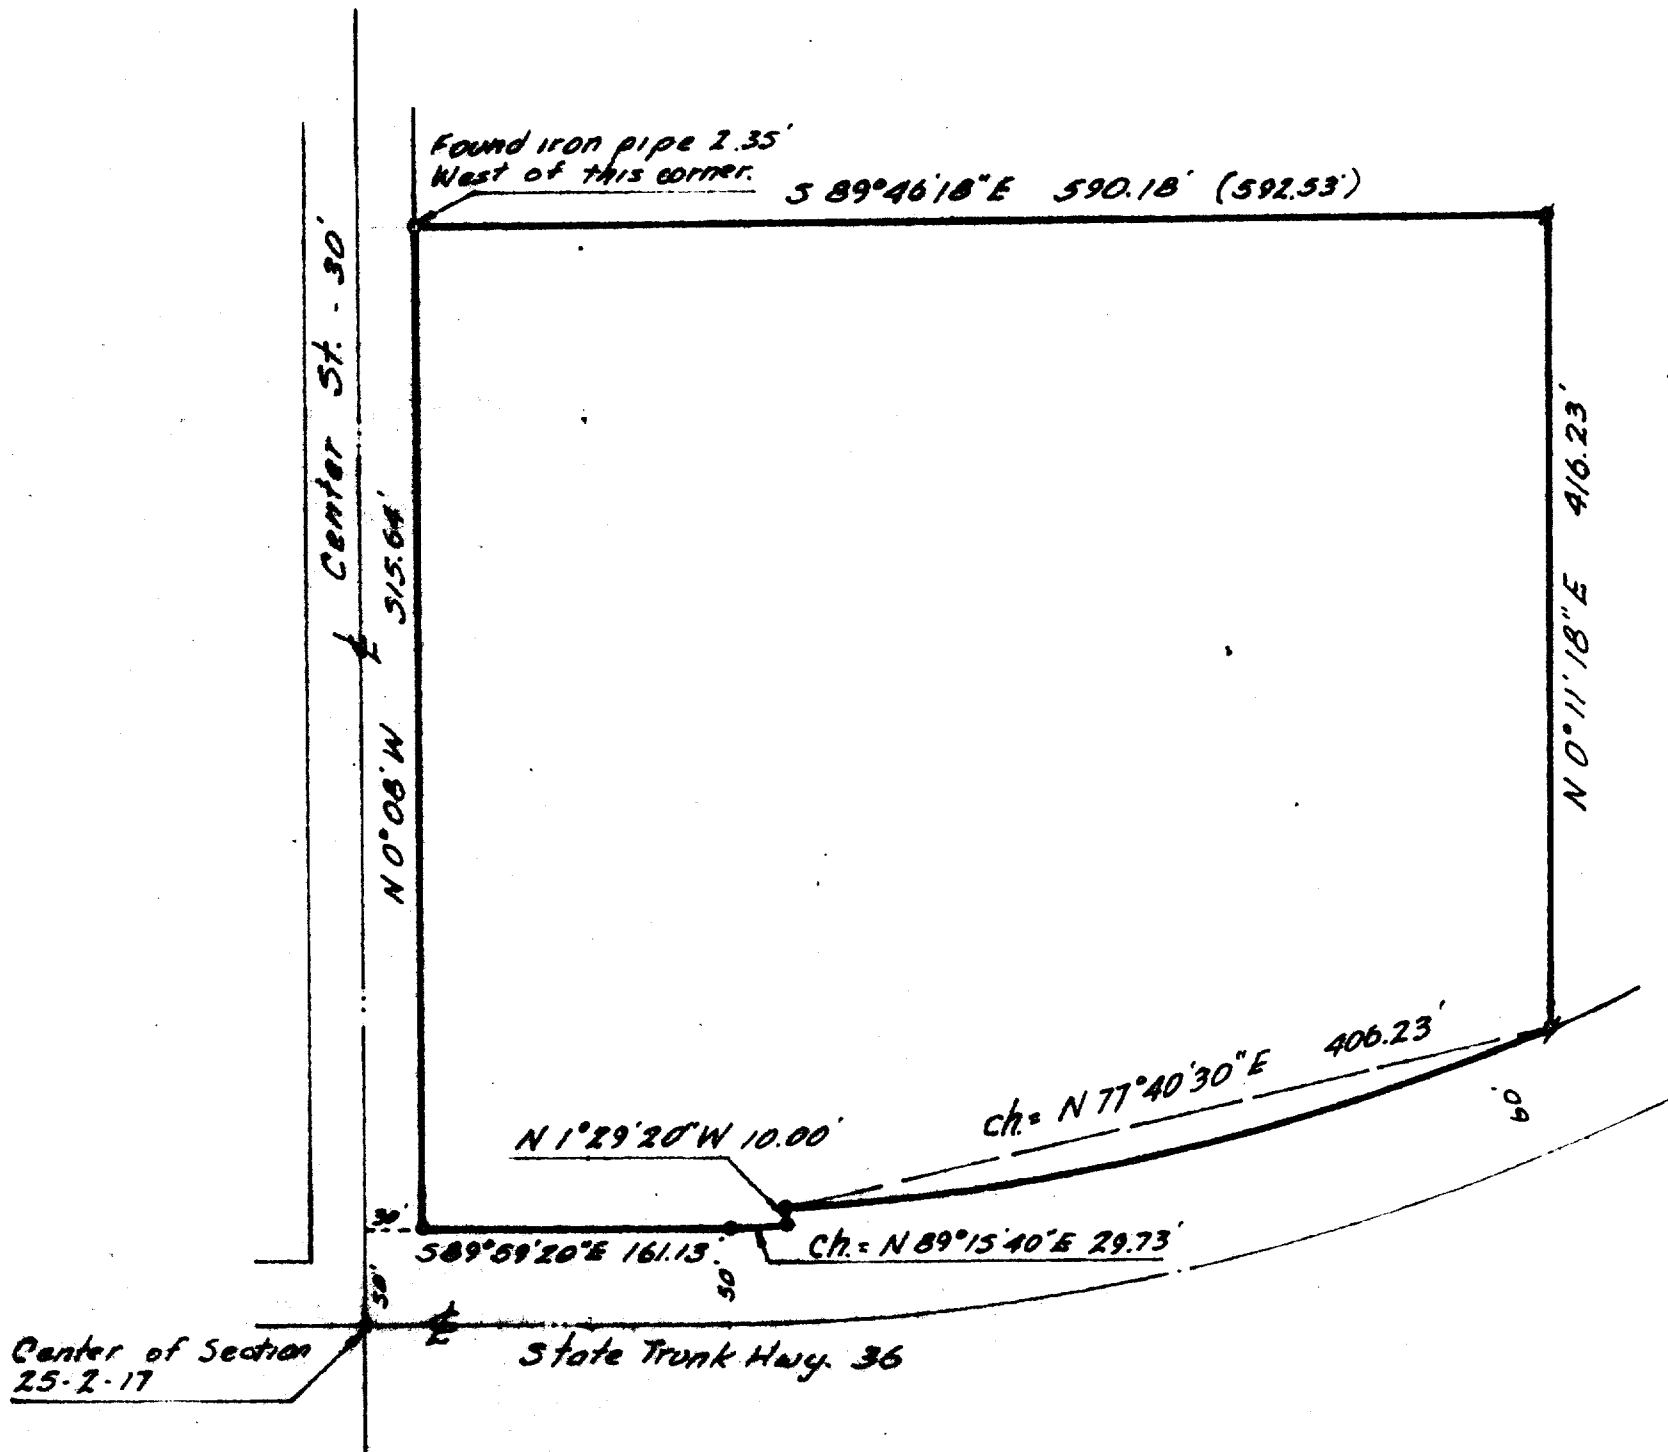


PLAT OF SURVEY OF

A parcel of land located in the NE $\frac{1}{4}$  of Section 25, T 2 N, R 17 E, City of Lake Geneva, Walworth County, Wisconsin described as follows: Commencing at the center of said Section 25; thence N 0° 08' W 50.00 feet; thence S 89° 59' 20" E 30.00 feet to the place of beginning; thence N 0° 08' W 515.64 feet; thence S 89° 46' 18" E 590.18 feet; thence S 0° 11' 18" W 416.23 feet to the Northerly right of way line of State Trunk Highway 36; thence along the arc of a curve to the right, the radius being 1086.28 feet and the chord bearing S 77° 40' 30" W 406.23 feet along said right of way; thence S 1° 29' 20" E 10.00 feet; thence along the arc of a curve to the right, the radius being 1096.28 feet and the chord bearing S 89° 15' 30" W 29.73 feet; thence W 89° 59' 20" W 161.13 feet to the place of beginning.

Containing 6.83 acres.

Note: Old description does not match relocated highway.

The bearing on the East line of Center St. is assumed from previous survey records.

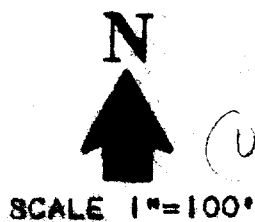

**LEGEND**

- ⌵ - IRON PIPE FOUND
- - IRON PIPE PLACED
- - CONCRETE MONUMENT
- ✕ - SPIKE
- ( ) - RECORDED AS



I, HAROLD H. KOLB, DO HEREBY CERTIFY THAT I HAVE SURVEYED THE PROPERTY HEREON DESCRIBED ACCORDING TO THE OFFICIAL RECORDS, AND THAT THE PLAT HEREON IS A CORRECT REPRESENTATION OF THE LOT LINES.

*Harold H. Kolb*  
HAROLD H. KOLB  
WISCONSIN REGISTERED LAND SURVEYOR, S-187  
DATE July 14, 1972

UP-140  
UP-140A

7-403