

1. Turn the instrument Glass, with the top of the original toward the BACK of the Cover. Close the Cover.
2. Select the desired quantity and press the


start button.

1. Turn the instrument Glass, with the top of the original toward the BACK of the Cover. Close the Cover.
2. Place original face downward in the instrument Glass. Close the Cover.
3. Set the Quantity Selector to the start button.

Mrs. Lee's lot was recorded at Elk Horn, 54 ft. N & S, and 130 ft. East & West.
J. C. Skeels C. E.,
Bessie Palmer, Asst.
APR. 4, 1922
Scale 100' to 1"

North

William Street

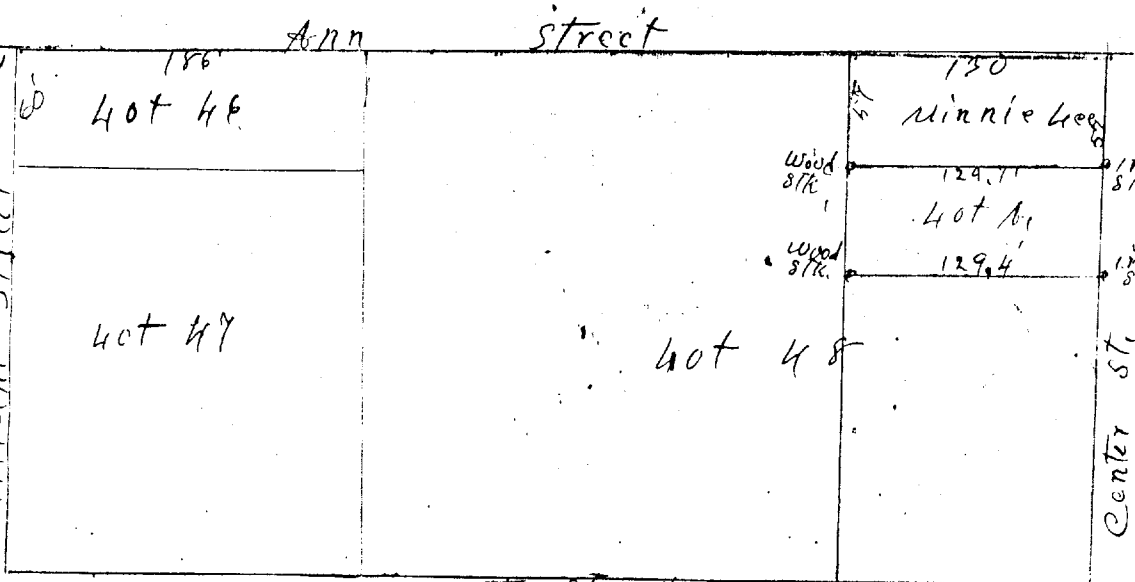

Charges 114.44

By request of Mrs. Geo. Diller we have surveyed and staked as indicated lot marked 'A' hereon 54' N & S, beginning 54' south of N.E. cor. of large lot 48, Fergusons addition to Geneva Village, thence west in the south line of land owned and occupied by Mrs. Minnie Lee 130' more or less to Mrs. Lees west line; thence south 54' thence East to west line of Center St. thence northerly in said west line 54' to place of beginning.

40	68.0	68.2	68.3	68.5	68.6	68.8	68.9	69.1	69.2	69.4	69.5
----	------	------	------	------	------	------	------	------	------	------	------

Example—If point is 22.6 ft. above grade, how far should it be from center line to be a slope stake point? Ans. from Table 41.9. For same slopes but other widths of roadbed correct above figures by one-half difference in width of roadbed; thus in example above for 20 ft. roadbed distance will be $41.9 + (20 - 10) \div 2$ or 2 ft. added to 41.9 = 43.9. For slopes of 1 on 1 see inside of front cover.

Copyright, 1914, by Eugene Dietzgen Co. Made in Germany.

Lot 48 Fergusons Add.

BF-57

7-427-Sk

DISTANCE FROM CENTER OF ROADWAY FOR

ING.
Slopes 1 on 1 1/2.
Inkment.

.6	.7	.8	.9	11
8.9	9.1	9.2	9.4	0
10.4	10.6	10.7	10.9	1
11.9	12.1	12.2	12.4	2
68.9	69.1	69.2	69.4	40