


LOCATED IN THE NE 1/4 OF THE NE 1/4 OF SECTION 1, TOWN 1 NORTH, RANGE 17 EAST,  
CITY OF LAKE GENEVA, WALWORTH COUNTY, WISCONSIN

LOCATED IN THE NE 1/4 OF THE NE 1/4 OF SECTION 1, TOWN 1 NORTH, RANGE 17 EAST,  
CITY OF LAKE GENEVA, WALWORTH COUNTY, WISCONSIN

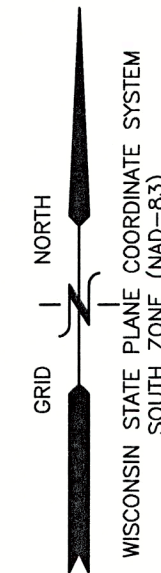

- = IRON REBAR FOUND 3/4" O.D.
- {xxx} = RECORDED AS
- XXXX.X = GRADE AT LOT CORNERS

- = IRON REBAR FOUND 3/4" O.D.
- {xxx} = RECORDED AS
- XXXX.X = GRADE AT LOT CORNERS

**AS-BUILT**  
LOT 18, SUMMRHAVEN OF LAKE GENEVA  
LAKE GENEVA, WI 53147

BASSO BUILDERS, INC. (JOSH BASSO)  
405 SKYLINE DRIVE  
LAKE GENEVA, WI 53147

7 RIDGWAY COURT P.O. BOX 437  
ELKHORN, WISCONSIN 53121  
PHONE: (262) 723-2098 e-mail: office@farrishansen.c

REVISIONS

REVISIONS

SUBJECT NO.	868.18
DATE:	08/2023
SHEET NO.	1 OF 1

SUBJECT NO.	868.18
DATE:	08/2023
SHEET NO.	1 OF 1

I HEREBY CERTIFY THAT THE ABOVE DESCRIBED PROPERTY HAS BEEN SURVEYED UNDER MY DIRECTION AND THAT THE ABOVE MAP IS A TRUE REPRESENTATION THEREOF AND SHOWS THE SIZE AND LOCATION OF THE PROPERTY AND ITS EXTERIOR BOUNDARIES. THIS SURVEY IS MADE FOR THE USE OF THE PRESENT OWNERS OF THE PROPERTY, AND ALSO THOSE WHO PURCHASE, MORTGAGE, OR GUARANTEE THE TITLE THERETO WITHIN ONE YEAR FROM THE DATE HEREOF.

CHRISTOPHER A. HODGES P.L.S. 2760

CHRISTOPHER A. HODGES P.L.S. 2760

WISCONSIN  
 CHRISTOPHER A.  
 HODGES  
 S-2760  
 ELKHORN,  
 WIS.  
 LAND SURVEYOR

EVAN DRIVE  
(50' WIDE R.O.W.)

EVAN DRIVE  
(50' WIDE R.O.W.)

X:\Projects\8868\8868\_18\ACAD\8868\_18.dwg

ZSUM2-18

007-4280