


ASSIGNED THE SOUTHERLY RIGHT OF WAY BOUNDARY  
OF MAIN STREET N 78°58'04" E

PLAT OF SURVEY  
TAX PARCEL ZYUP 00094M  
LOCATED IN PART OF THE SE 1/4 OF THE NE 1/4 OF SECTION 35, TOWN 2 NORTH,  
RANGE 17 EAST, CITY OF LAKE GENEVA, WALWORTH COUNTY, WISCONSIN

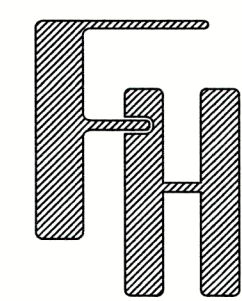


PLAT OF SURVEY  
1334 W. MAIN STREET,  
LAKE GENEVA, WISCONSIN

WORK ORDERED BY -  
LOWELL CUSTOM HOMES  
401 GENEVA NATIONAL AVENUE SOUTH 6  
LAKE GENEVA, WI 53147

FARRIS, HANSEN & ASSOCIATES, INC.  
ENGINEERING - ARCHITECTURE - SURVEYING  
7 RIDGWAY COURT P.O. BOX 437  
ELKHORN, WISCONSIN 53121  
OFFICE: (262) 723-2098 FAX: (262) 723-5886

REVISIONS

PROJECT NO.  
10299.21  
DATE  
11/03/2023  
SHEET NO.  
1 OF 1

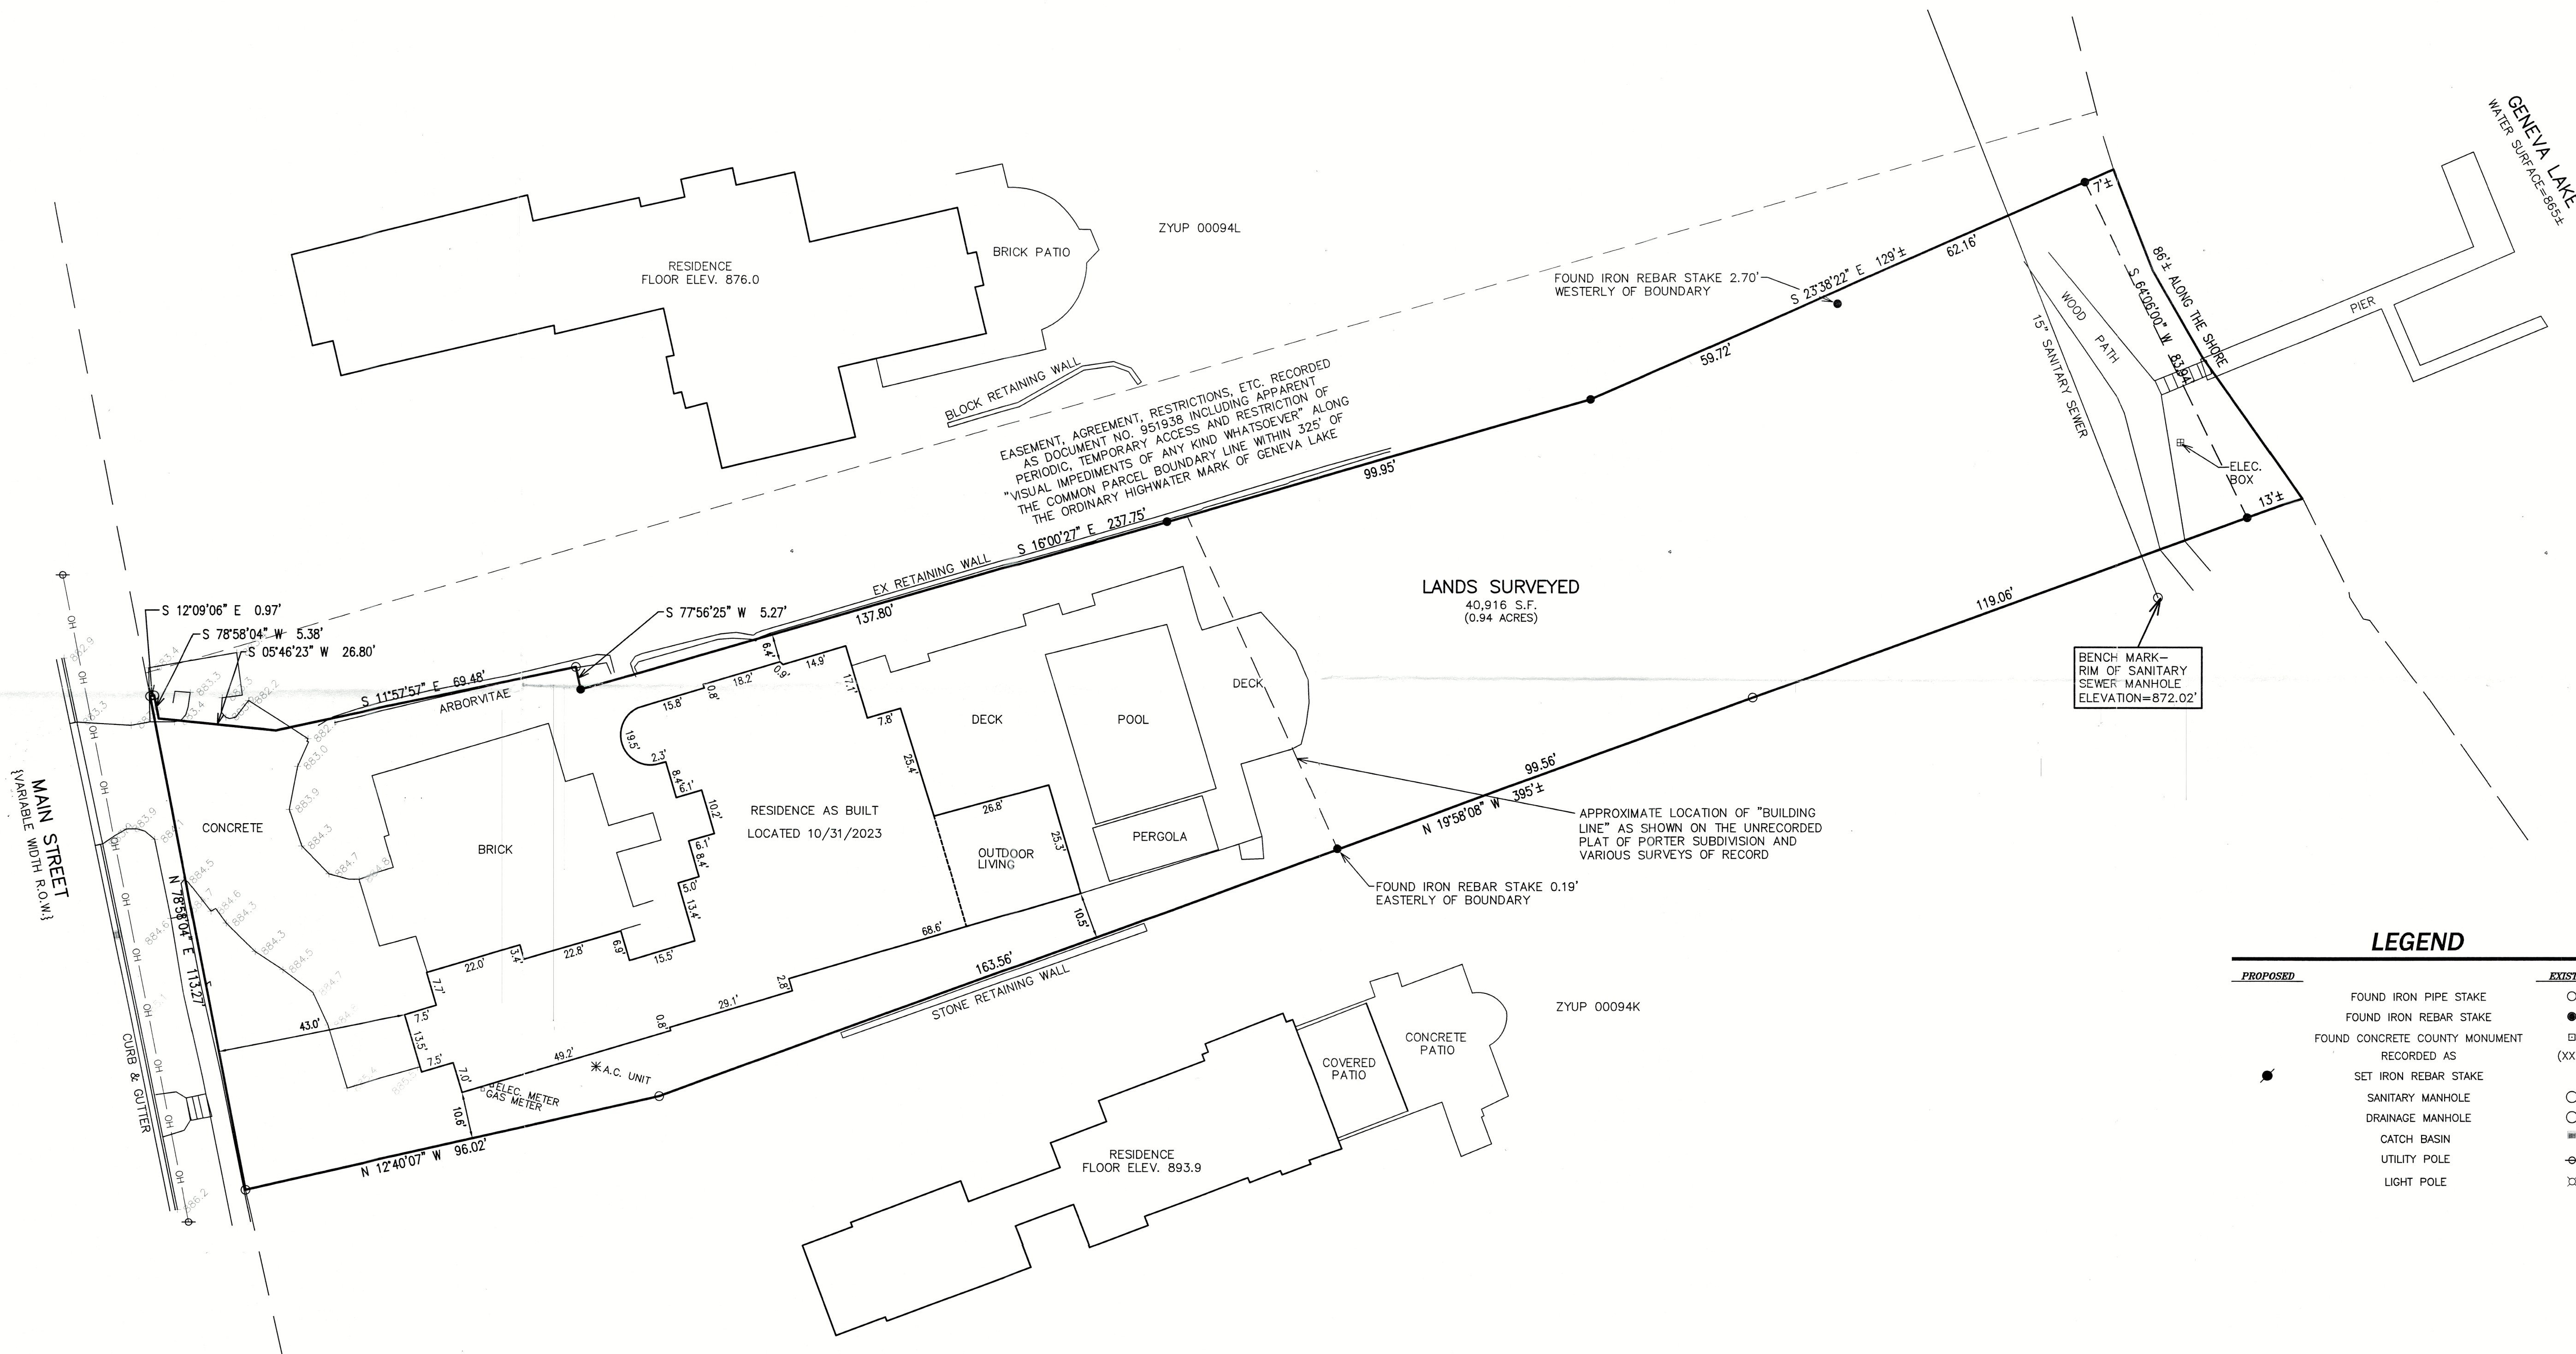

LEGEND

| PROPOSED                       | EXISTING |
|--------------------------------|----------|
| FOUND IRON PIPE STAKE          | ○        |
| FOUND IRON REBAR STAKE         | ●        |
| FOUND CONCRETE COUNTY MONUMENT | ■        |
| RECORDED AS                    | (XXX)    |
| SET IRON REBAR STAKE           | ○        |
| SANITARY MANHOLE               | ○        |
| DRAINAGE MANHOLE               | ○        |
| CATCH BASIN                    | ■        |
| UTILITY POLE                   | ⊕        |
| LIGHT POLE                     | ⊕        |


NOTE: COPIES OF THIS MAP TO WHICH THE FOLLOWING CERTIFICATE WILL APPLY SHOW  
THE SURVEYOR'S ORIGINAL SEAL AND SIGNATURE IN RED INK. COPIES BY ANY OTHER  
MEANS MAY HAVE ALTERATIONS WHICH DO NOT REPRESENT THE SURVEYOR'S WORK  
PRODUCT.

I HEREBY CERTIFY THAT THE ABOVE DESCRIBED PROPERTY HAS BEEN SURVEYED  
UNDER MY DIRECTION AND THAT THE ABOVE MAP IS A TRUE REPRESENTATION  
THEREOF AND SHOWS THE SIZE AND LOCATION OF THE PROPERTY AND ITS EXTERIOR  
BOUNDARIES. THIS SURVEY IS MADE FOR THE USE OF THE PRESENT OWNERS OF THE  
PROPERTY, AND ALSO THOSE WHO PURCHASE, MORTGAGE, OR GUARANTEE THE TITLE  
THERETO WITHIN ONE YEAR FROM THE DATE HEREOF.

DATED: 05/14/2021

REVISED 11/3/2023 TO SHOW  
RESIDENCE AS BUILT.

CHRISTOPHER A. HODGES P.L.S. S-2760

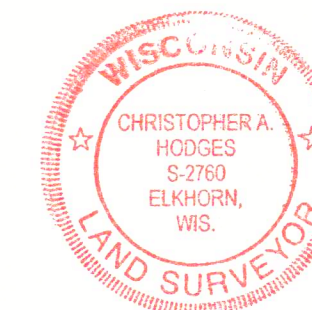

MAP SCALE IN FEET - ORIGINAL 1"=20'

ZYUP-94M

007-488X