


Survey No.
18-0033.163

TAX ID: ZSR 000163

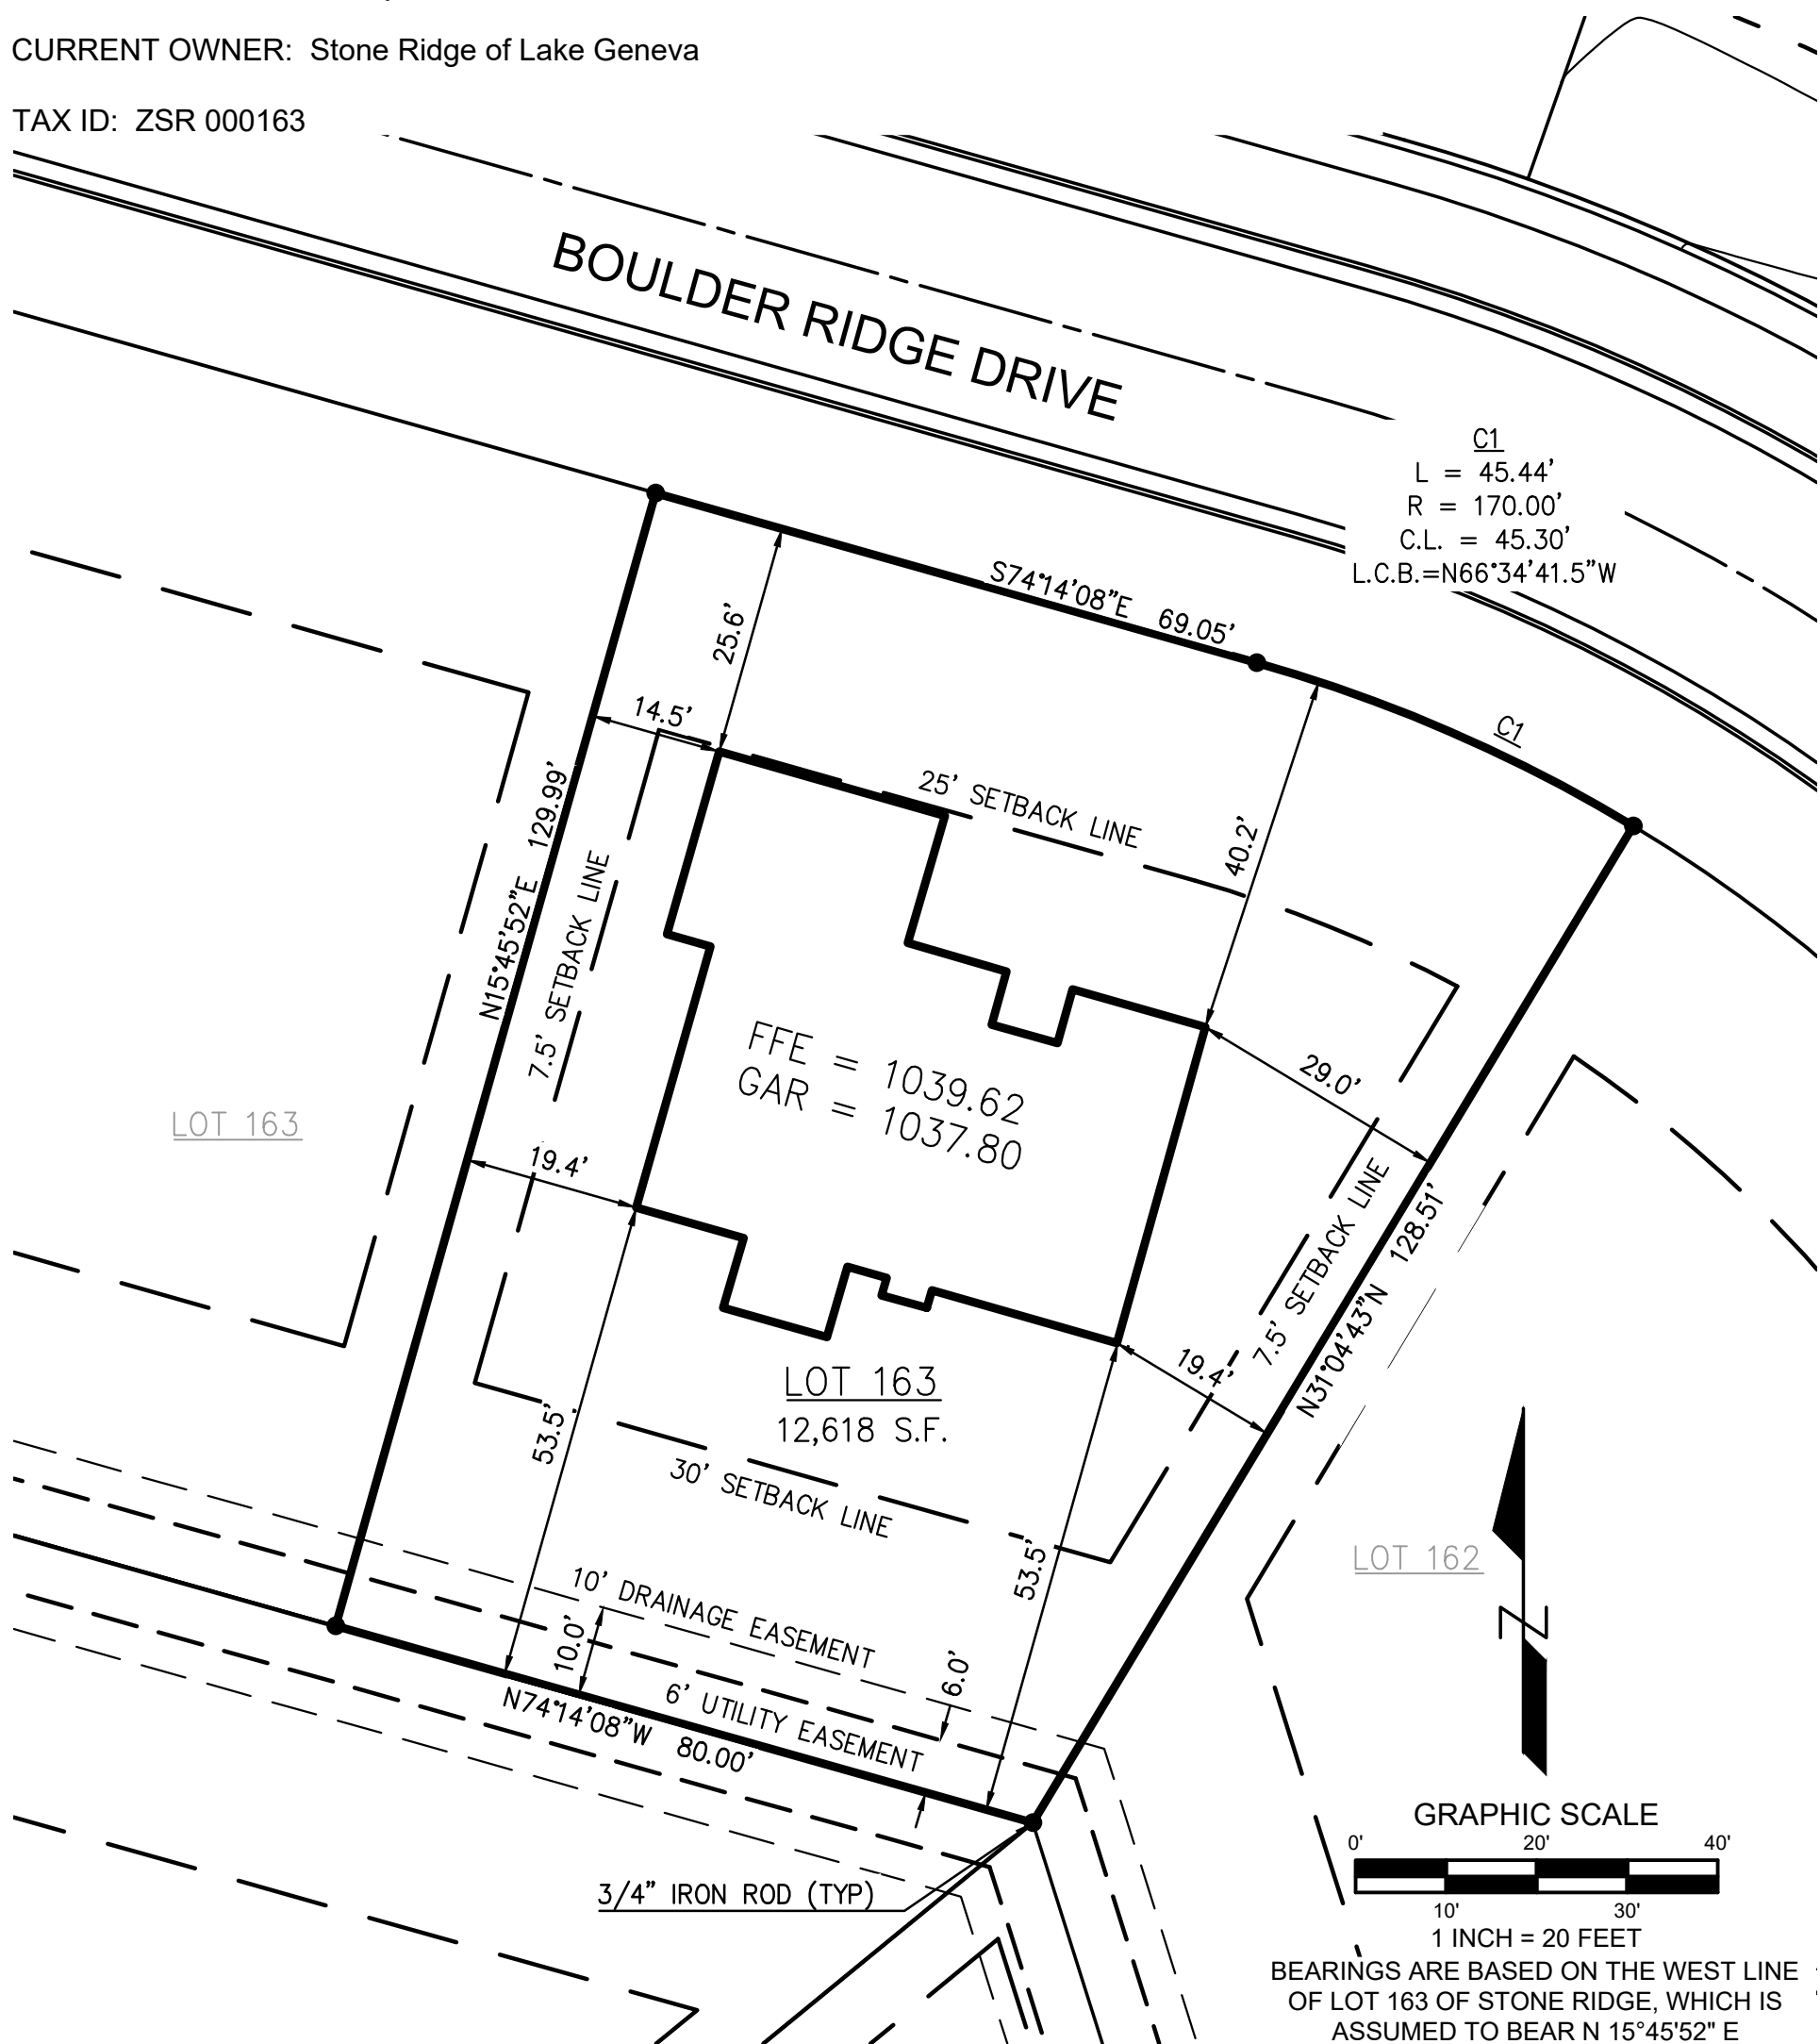


Rick R. Hillmann, Professional Land Surveyor, S-3005