



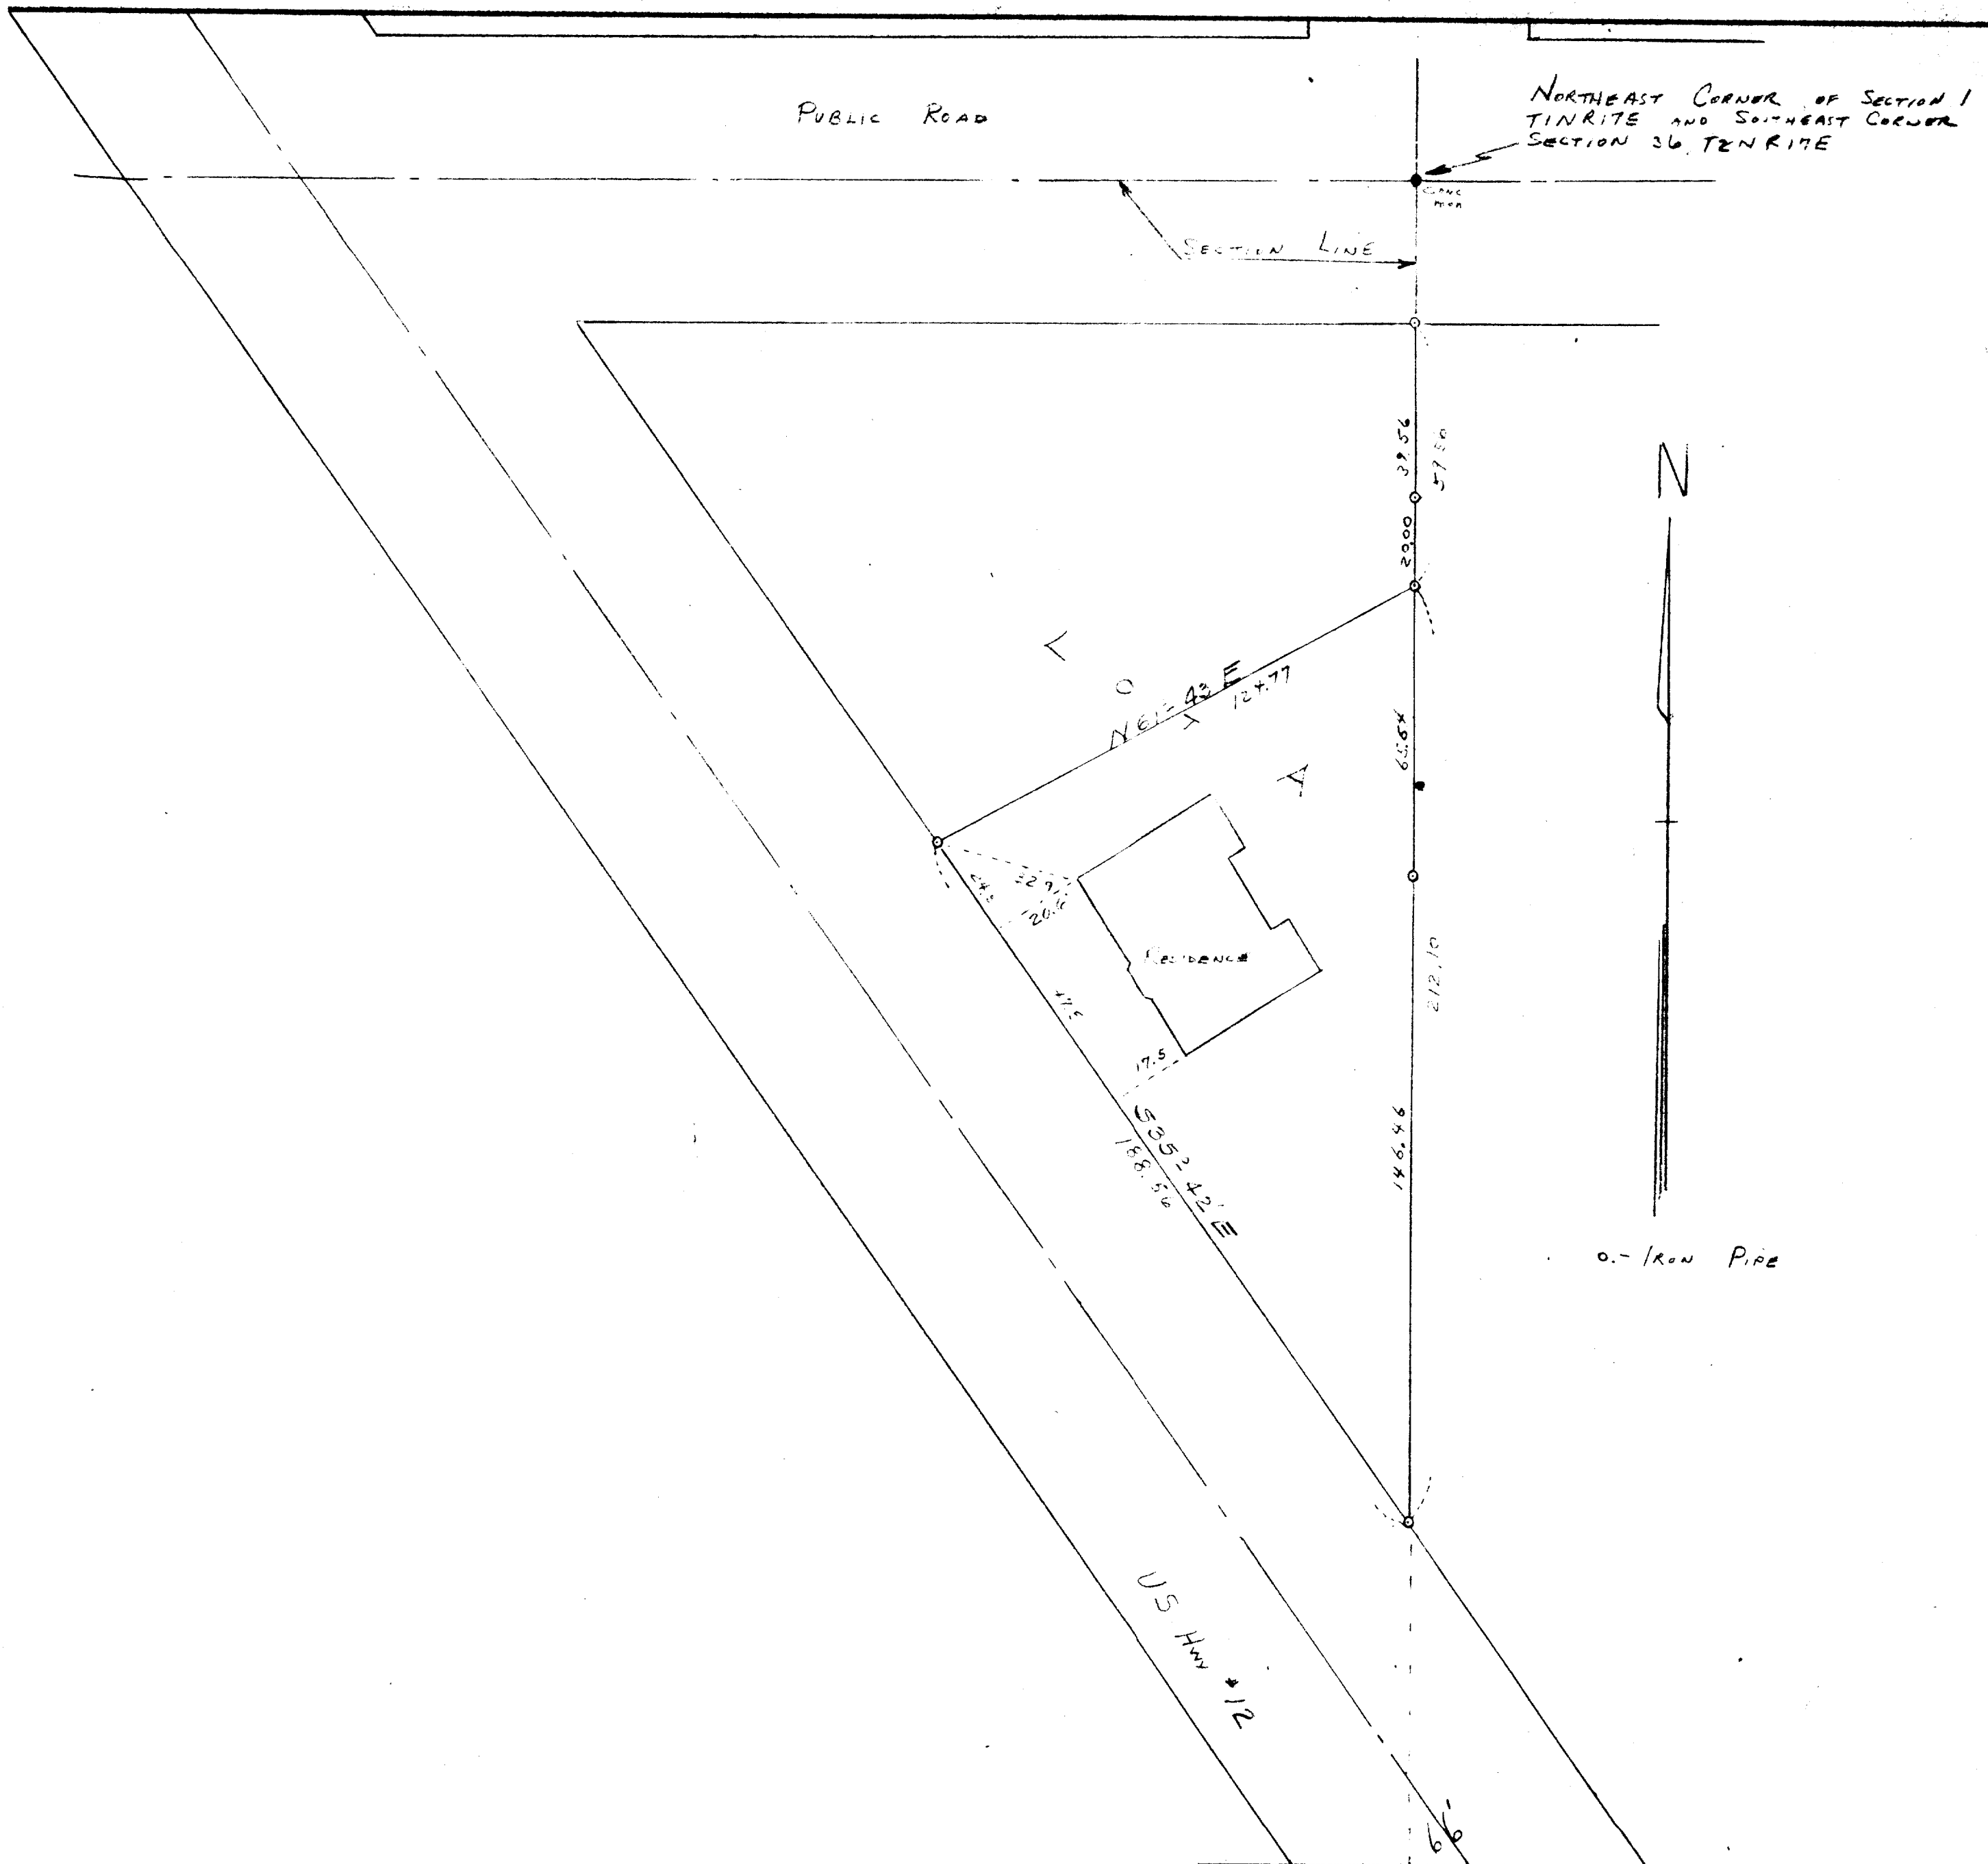

PLAT OF SURVEY OF

LOT A OF BOULEVARD SUBDIVISION
LOCATED IN
SECTION 1, T1N R17E,
CITY OF LAKE GENEVA,
WALWORTH COUNTY, WISCONSIN

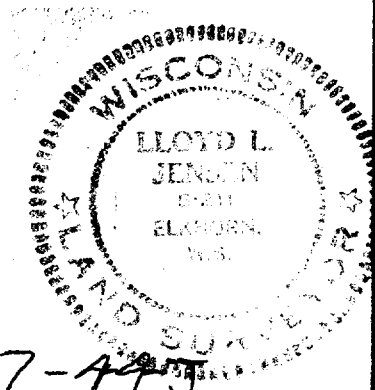

Lloyd L. Jensen
SURVEYOR

SCALE 1" = 30'

DATE May 1956

BL-1 and BL-2

7-475