


NOV 1 1973

**REGISTERED PROFESSIONAL LAND SURVEYOR
LAKE GENEVA, WISCONSIN**

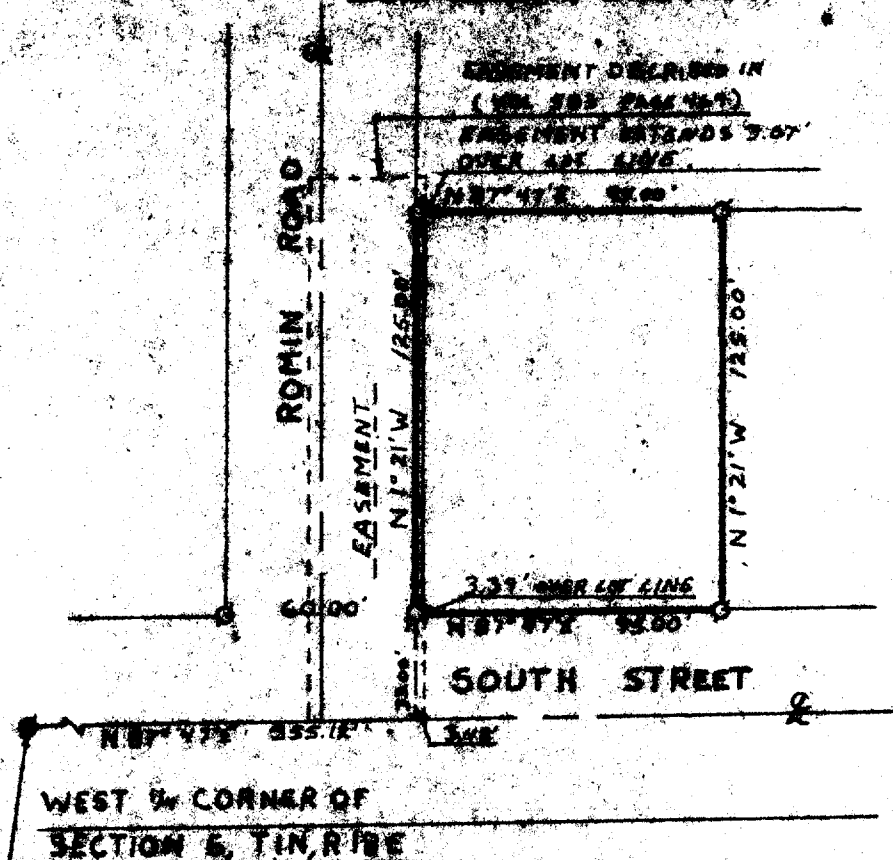

PLAT OF SURVEY OF

A parcel of land located in the Northwest 1/4 of Section 6, T 1 N, R 18 E, and described as follows: Commencing at the West 1/4 corner of said Section 6, T 1 N, R 18 E, thence N 87° 47' E 355.12 feet; thence N 1° 21' W 33.00 feet to the place of beginning of land to be described; thence continue North 1° 21' W 125.00 feet; thence North 87° 47' East 95.00 feet; thence South 1° 21' East 125.00 feet; thence South 87° 47' West 95.00 feet to the place of beginning. Said land being in the City of Lake Geneva, Walworth County, Wisconsin.

SCALE - 1"=60'

LEGEND

- ✦ - IRON PIPE FOUND
- - IRON PIPE PLACED
- - CONCRETE MONUMENT
- x - SPIRE



I, HAROLD H. KOLL, DO HEREBY CERTIFY THAT I HAVE SURVEYED THE PROPERTY HEREON DESCRIBED ACCORDING TO THE OFFICIAL RECORDS AND THAT THE PLAT HEREON IS A CORRECT REPRESENTATION OF THE LOT LINES.

Harold H. Koll
HAROLD H. KOLL
WISCONSIN REGISTERED LAND SURVEYOR, S-187
DATE October 30, 1973

7-456