

RONALD H. ZIMMERMAN
REGISTERED LAND SURVEYOR


PLAT OF SURVEY

FOR

WAUKESHA SAVINGS & LOAN

GEORGE

STREET

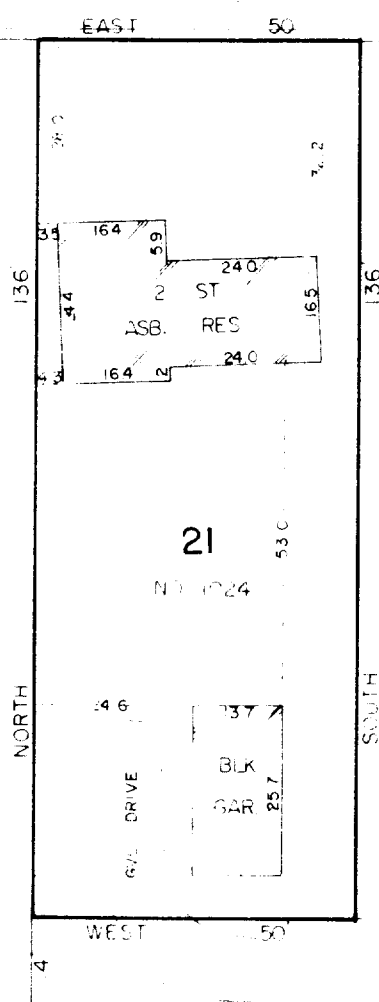

SCALE 1" = 30'

ALLEY

STATE OF WISCONSIN
COUNTY OF WAUKESHA

CERTIFICATION

I, RONALD H. ZIMMERMAN, REGISTERED LAND SURVEYOR, DO HEREBY CERTIFY THAT I HAVE MADE A SURVEY
OF LOT 21, WATSON'S BLVD. ADD. CITY OF LAKE GENEVA, WALWORTH CO.
AND THE EXISTING BUILDING AND IMPROVEMENTS LOCATED THEREON AND THAT THE PLAT HEREWITH DRAWN
IS A CORRECT REPRESENTATION OF SAID SURVEY.

DATE NOV 30 1973

RONALD H. ZIMMERMAN

S 868

7-468