


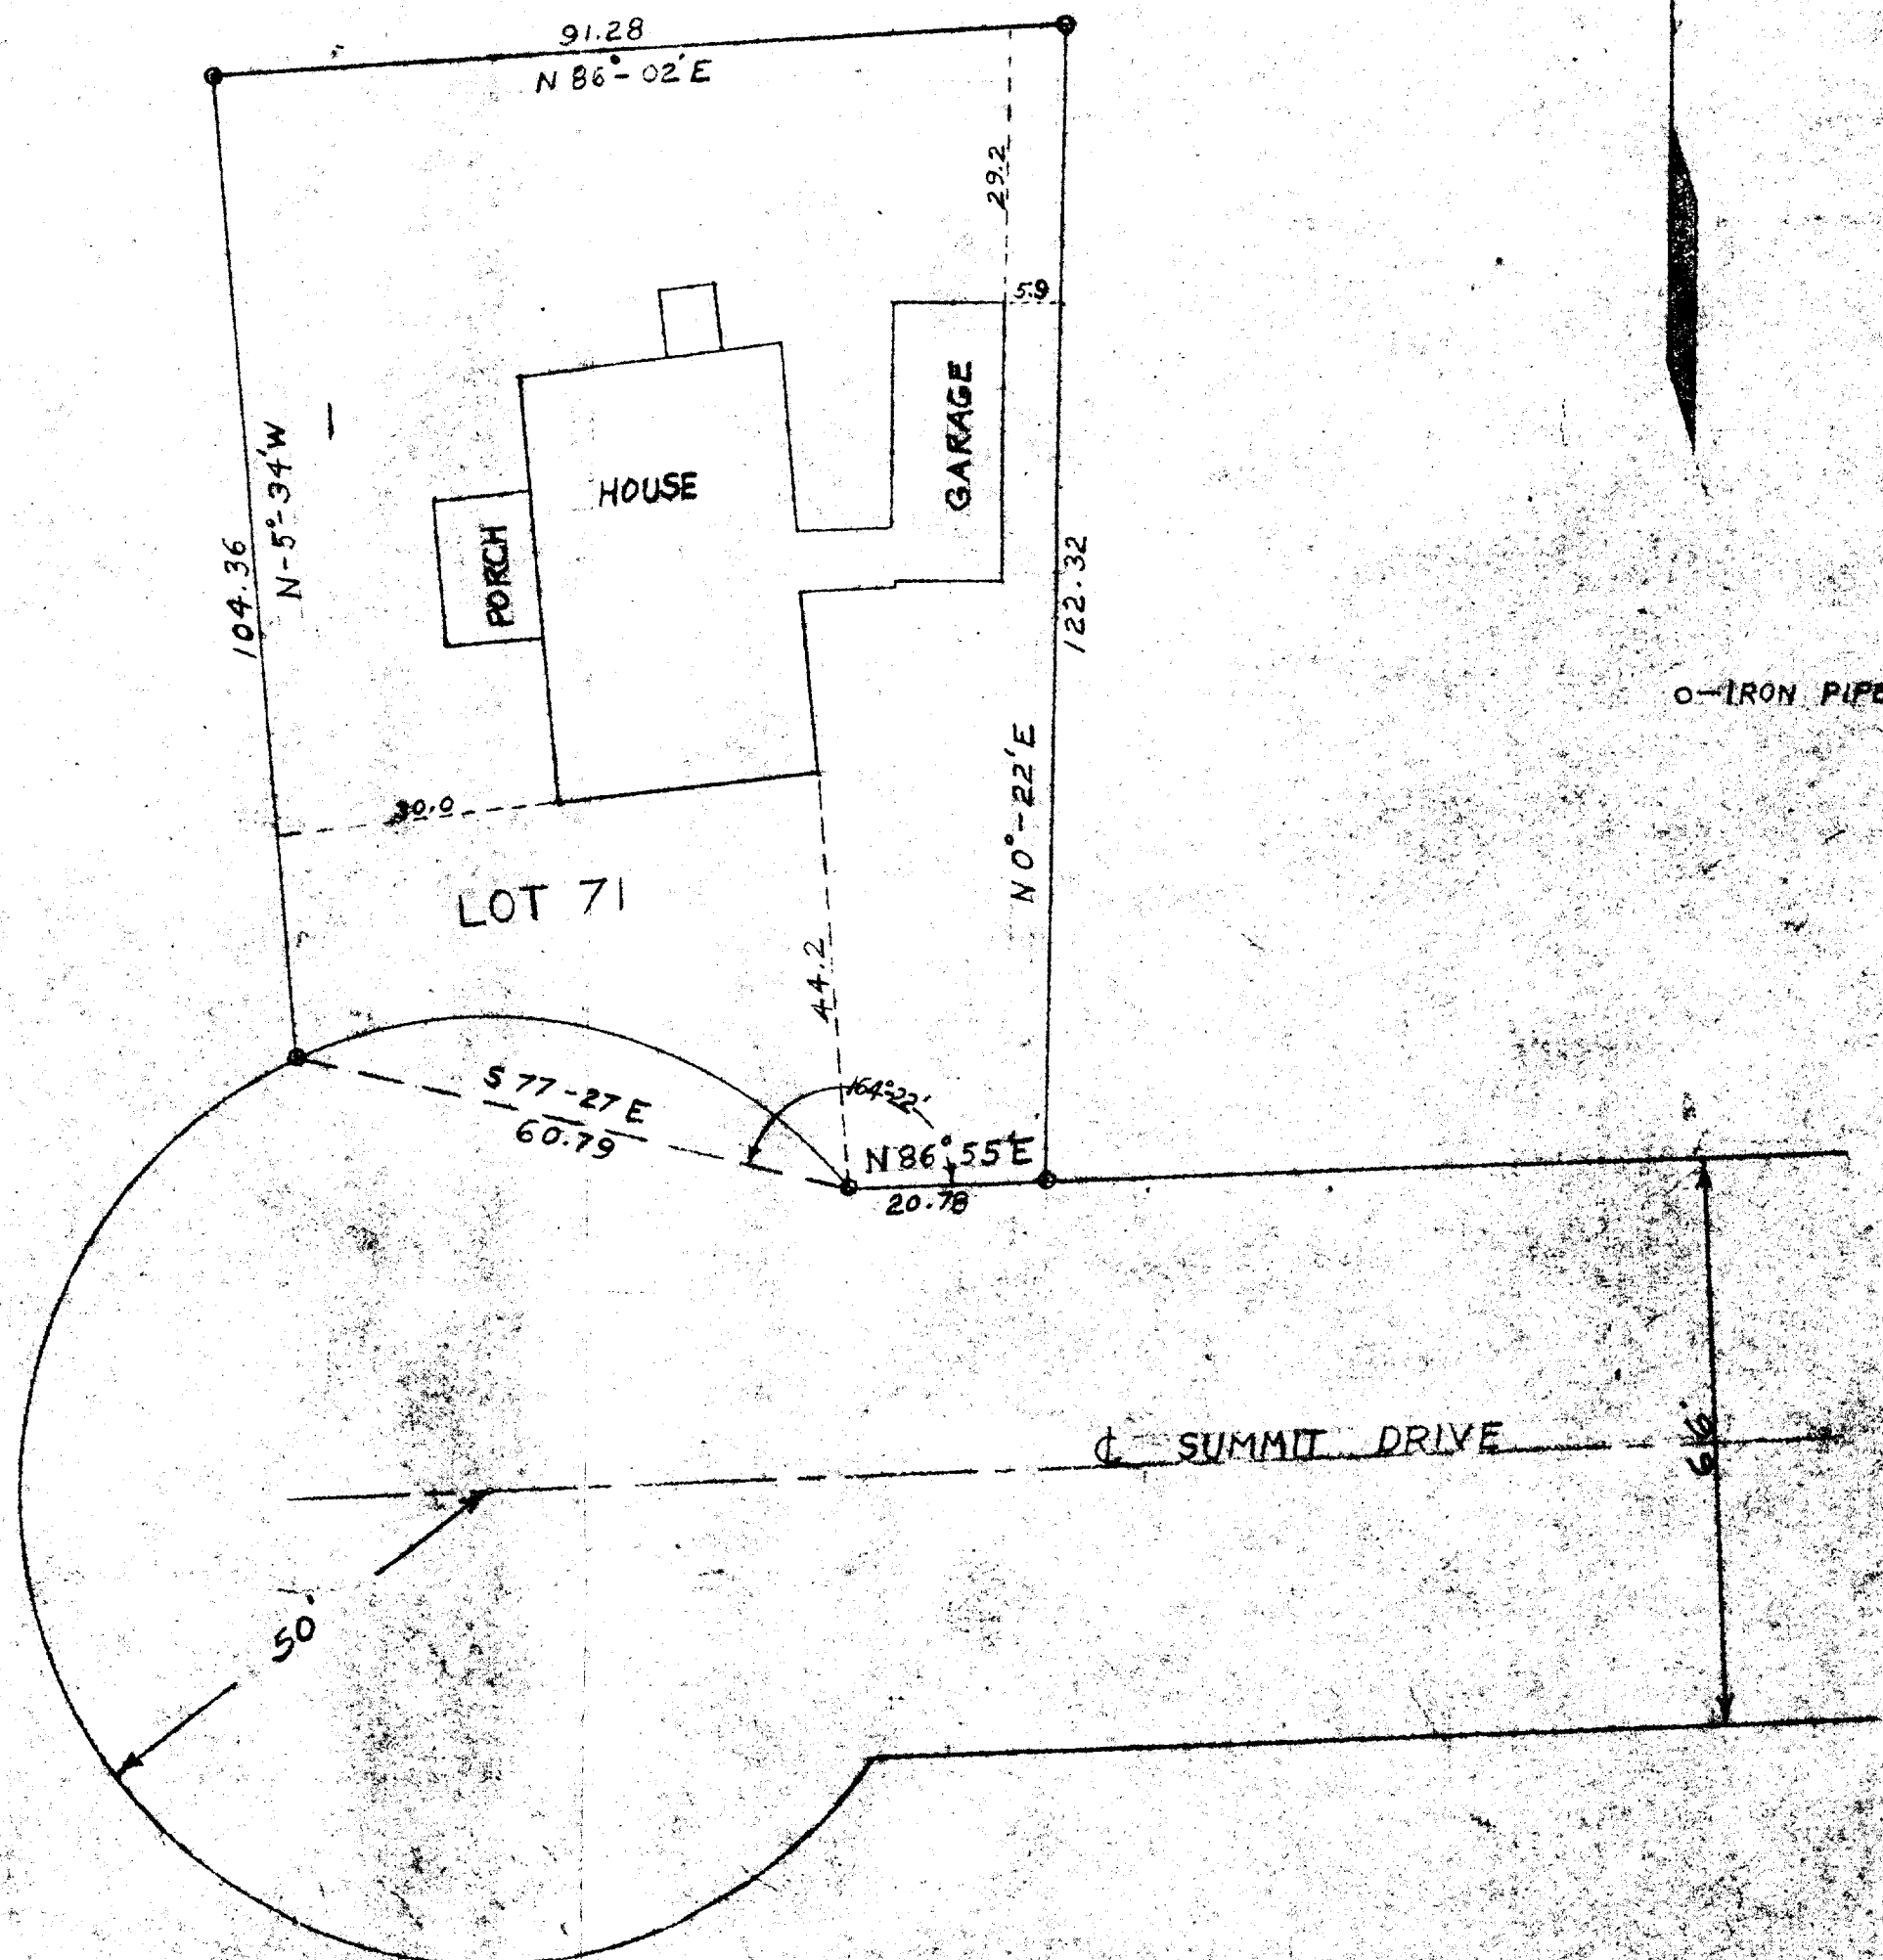

STATE OF WISCONSIN
COUNTY OF WALWORTH

I, LLOYD L. JENSEN, DO, HEREBY CERTIFY THAT I HAVE SURVEYED
THE PROPERTY DESCRIBED HEREON ACCORDING TO THE OFFICIAL RECORDS
AND THAT THE PLAT HEREON IS A CORRECT REPRESENTATION OF THE
LOT LINES AND PRINCIPAL LINES OF BUILDINGS THEREON.

2549-7

7-46J

ELKHORN, WISCONSIN NOV. 5, 1955

PLAT OF SURVEY OF

LOT 71 OF STURWOOD ADDITION NO. 3

LOCATED IN THE CITY OF LAKE GENEA

WALWORTH COUNTY WISCONSIN

[Signature]

PLAT - 20

DATE NOV. 5, 1955