


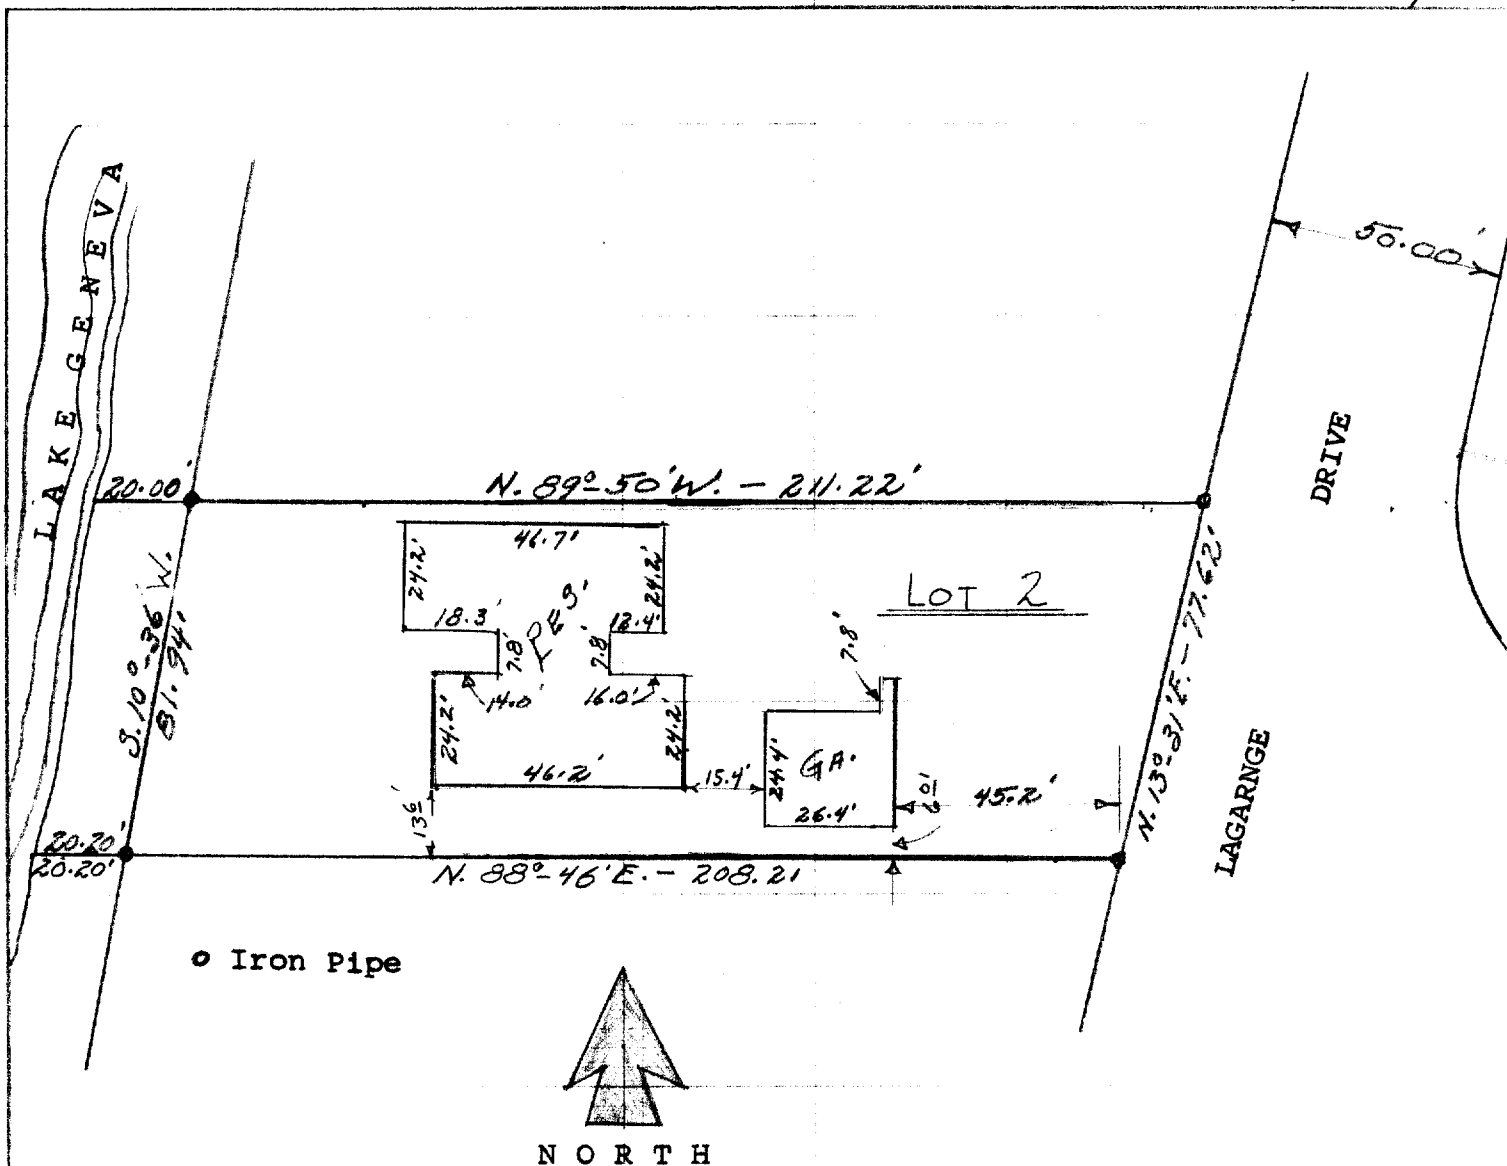

DESCRIPTION: Lot 2 of Lake Geneva East Shore Estates a subdivision of a portion of the City of Lake Geneva, Walworth County, Wisconsin.

CERTIFICATE: I, hereby certify that I have surveyed the above mentioned property and that the hereon portrayed is an accurate survey and a true representation thereof and correctly shows the exterior boundary lines and the location of the buildings and other improvements thereof.

Dated: May 22nd 1967.

James F. Biagi, RLS 272
Elkhorn, Wisconsin.

