


HAROLD H. KOLB

REGISTERED PROFESSIONAL LAND SURVEYOR

LAKE GENEVA, WISCONSIN

MILLER ROAD · 60' WIDE

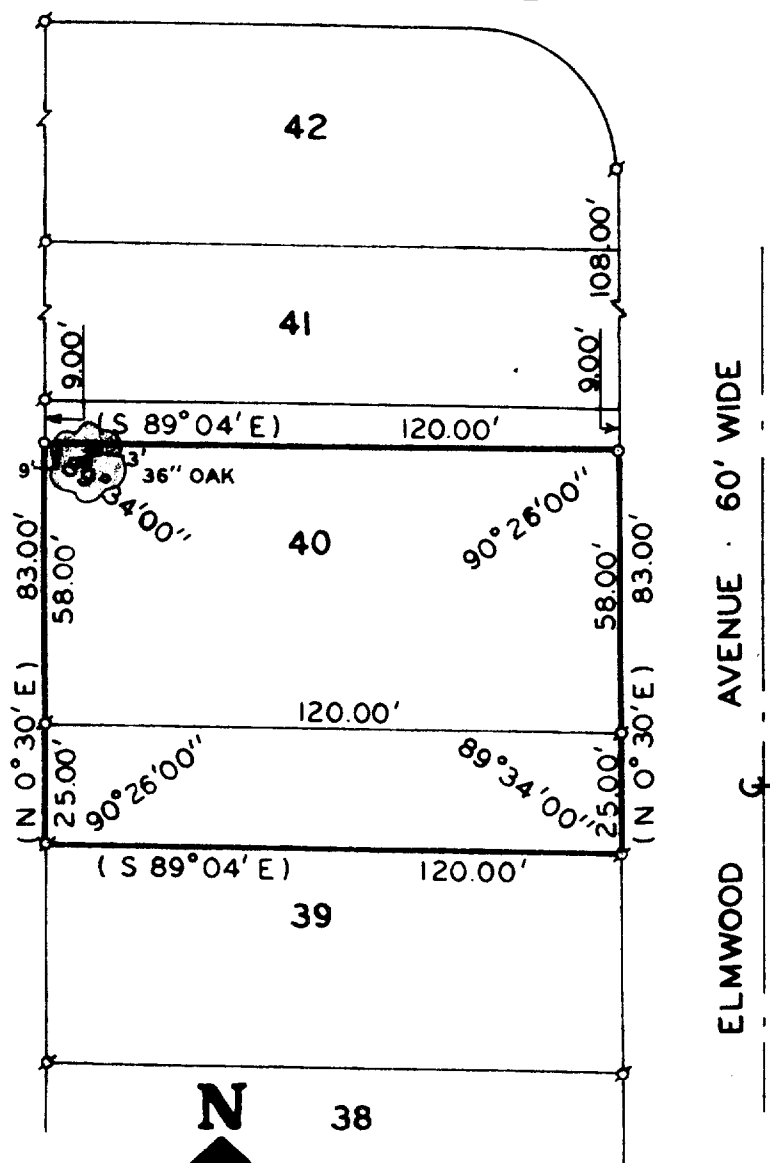

N

38

SCALE · 1" = 40'

LEGEND

- φ — IRON PIPE FOUND
- — IRON PIPE PLACED
- — CONCRETE MONUMENT
- x — SPIKE
- () — AS PLATTED



PLAT OF SURVEY OF

THE NORTH 25.00 FEET OF
LOT 39 AND THE SOUTH 58.00
FEET OF LOT 40, STURWOOD
SUBDIVISION, CITY OF LAKE
GENEVA, WALWORTH COUNTY,
WISCONSIN.

OWNER: EDWARD WEINBERG

ACCURACY: DISTANCE \pm 0.01'
ANGLES \pm 05"
ERROR OF CLOSURE
LESS THAN 1/3000

I, HAROLD H. KOLB, DO HEREBY CERTIFY THAT I HAVE
SURVEYED THE PROPERTY HEREON DESCRIBED ACCORDING
TO THE OFFICIAL RECORDS, AND THAT THE PLAT HEREON
IS A CORRECT REPRESENTATION OF THE LOT LINES.

Harold H. Kolb

HAROLD H. KOLB
WISCONSIN REGISTERED LAND SURVEYOR, S-187

DATE Aug 28, 1975

REVISED: SEPT. 11, 1975

ST-39

7-526