
HAROLD H. KOLB

REGISTERED PROFESSIONAL LAND SURVEYOR

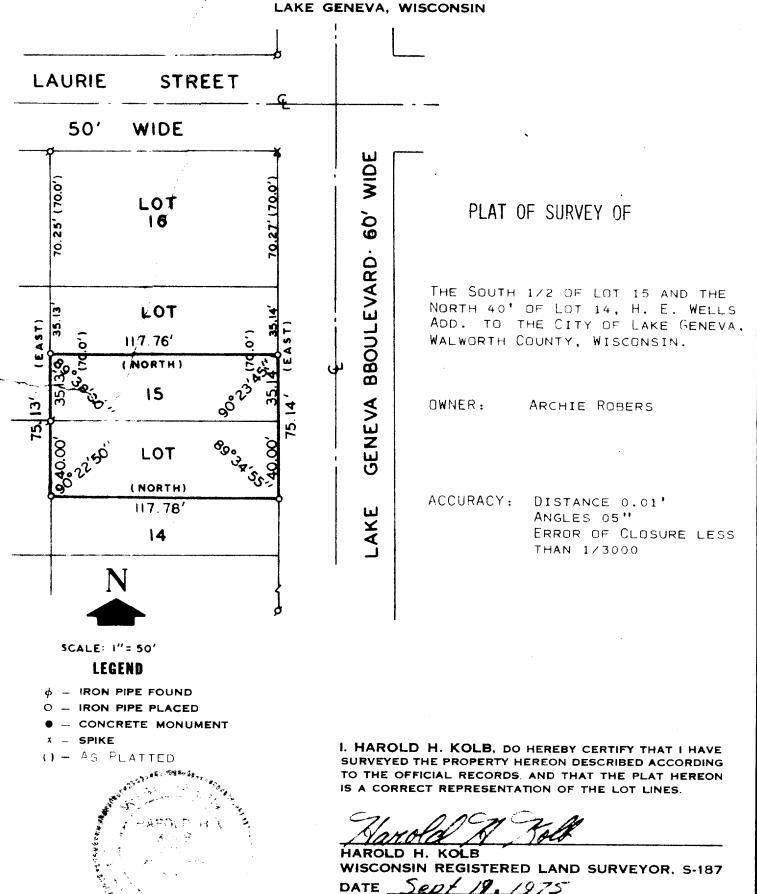

<u> 7 - 527</u>