


PLAT OF SURVEY

OF

LOT 3, BLOCK 15, CRAWFORD MANUFACTURING ADDITION, CITY OF LAKE GENEVA, WALWORTH COUNTY, WISCONSIN

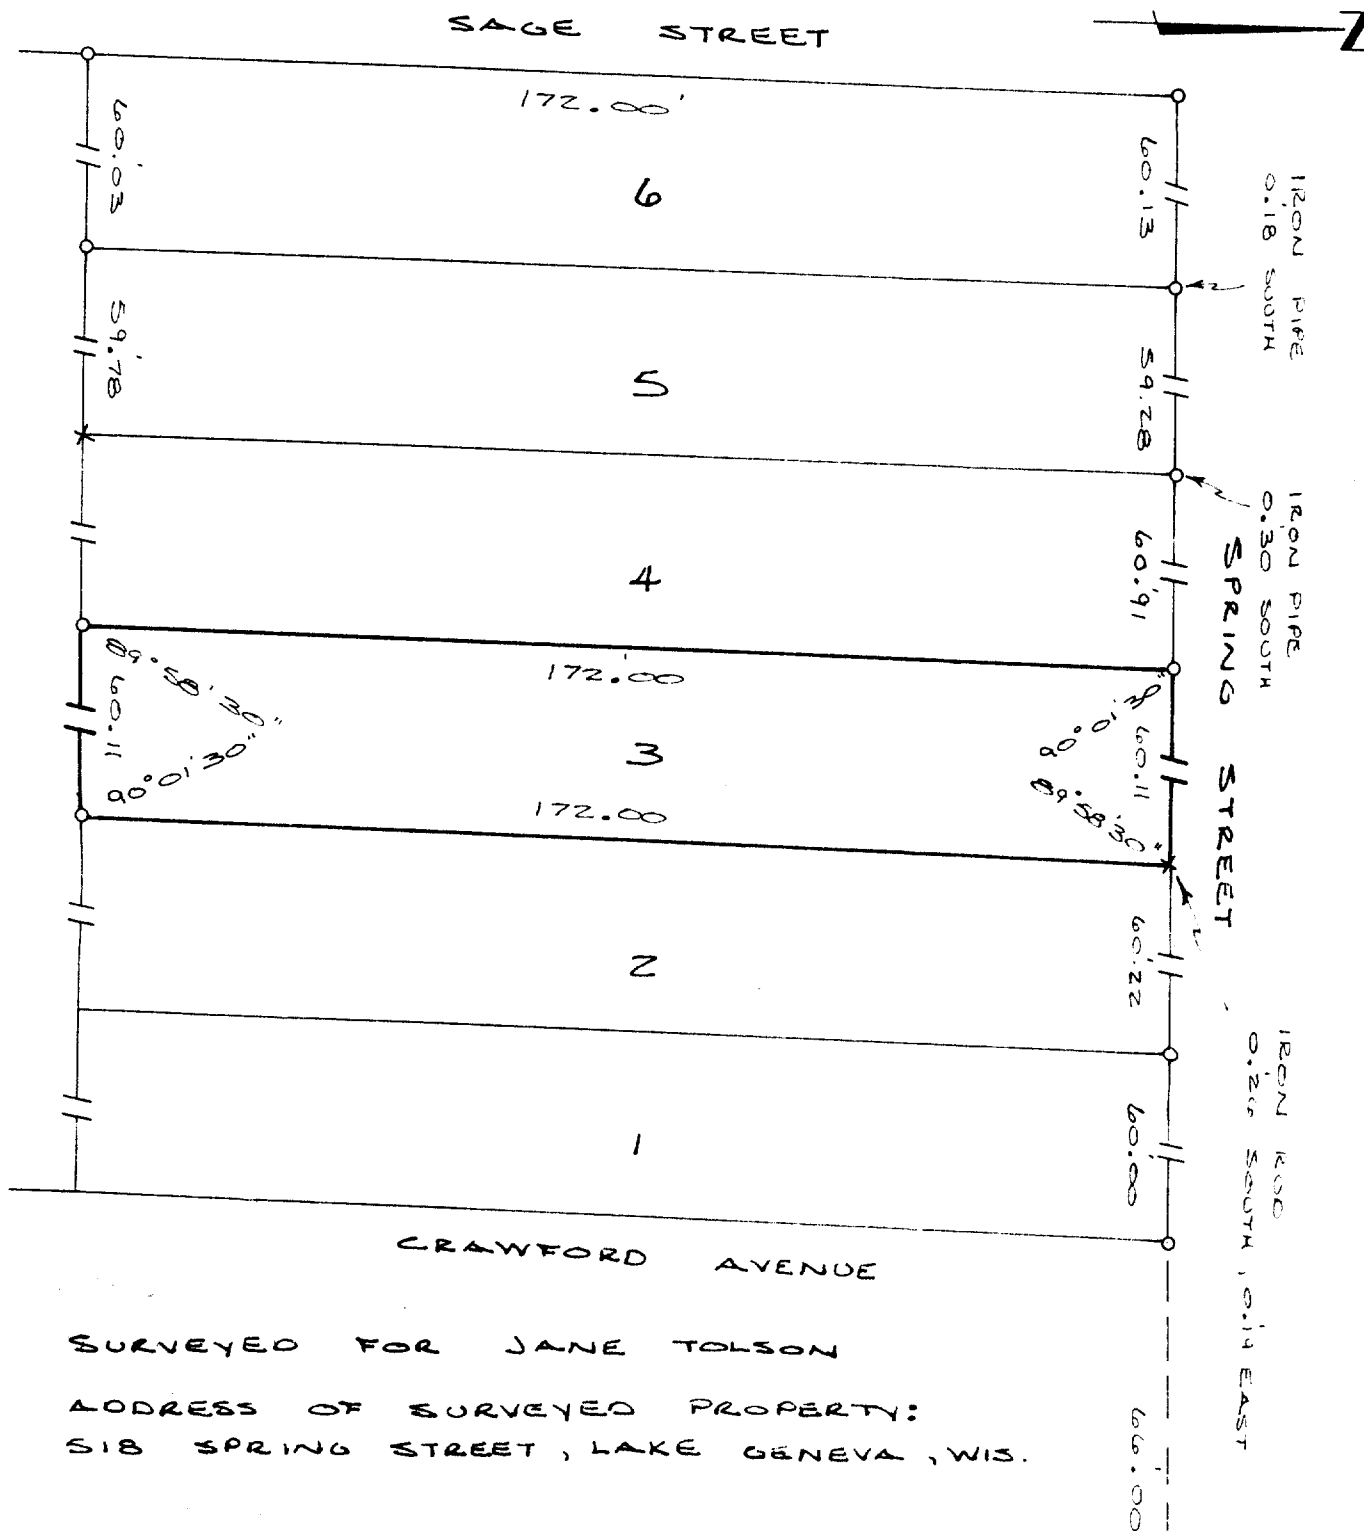

SURVEYED FOR JANE TOLSON
ADDRESS OF SURVEYED PROPERTY:
518 SPRING STREET, LAKE GENEVA, WIS.

SURVEY AND PLAT BY
JENSEN & JOHNSON, INC.
CIVIL ENGINEERS AND SURVEYORS

Elkhorn, Wisconsin

LEGEND

- — Iron Pipe
- — Concrete Monument
- Scale 1" = 30'
- X — SPIKE

WE CERTIFY: That we have surveyed the above described property and that the plat shown hereon is an accurate survey and a true representation thereof and correctly shows the exterior boundary lines and all divisions of said property.

Date JAN. 27, 1976

Lloyd L. Jensen
LLOYD L. JENSEN,

Wisconsin Registered Land Surveyor, No. S-211

24C-65A

7-539 J