


HAROLD H. KOLB

REGISTERED PROFESSIONAL LAND SURVEYOR
LAKE GENEVA, WISCONSIN

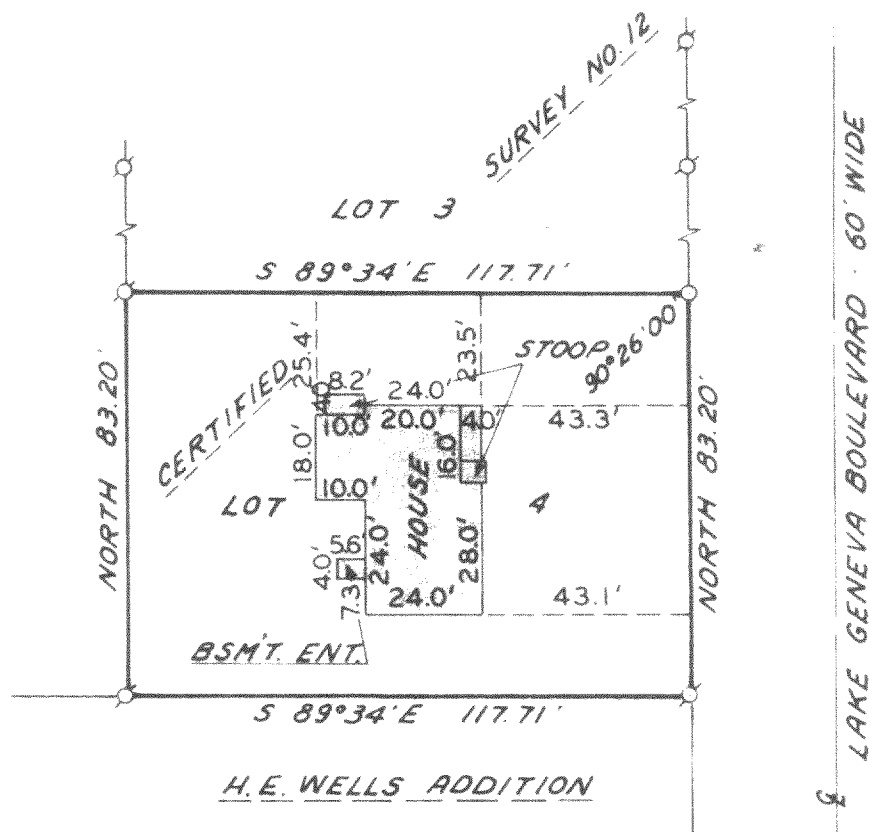

PLAT OF SURVEY OF

LOT 4 OF CERTIFIED SURVEY NO. 12, AS RECORDED
IN VOLUME 1 OF CERTIFIED SURVEY MAPS, PAGE 12,
WALWORTH COUNTY, WISCONSIN.

OWNER: JOE YUKNIE

ACCURACY: DISTANCE: ± 0.01
ANGLES: $\pm 15''$
ERROR OF CLOSURE: LESS THAN ONE PART
IN 3,000

N



SCALE: 1"=40'


LEGEND

- φ — IRON PIPE FOUND
- — IRON PIPE PLACED
- — CONCRETE MONUMENT
- x — SPIKE

I, HAROLD H. KOLB, DO HEREBY CERTIFY THAT I HAVE
SURVEYED THE PROPERTY HEREON DESCRIBED ACCORDING
TO THE OFFICIAL RECORDS AND THAT THE PLAT HEREON
IS A CORRECT REPRESENTATION OF THE LOT LINES, AND
THE PRINCIPLE BUILDING LINES THEREON.

Harold H. Kolb

HAROLD H. KOLB
WISCONSIN REGISTERED LAND SURVEYOR, S-187
DATE March 18, 1976

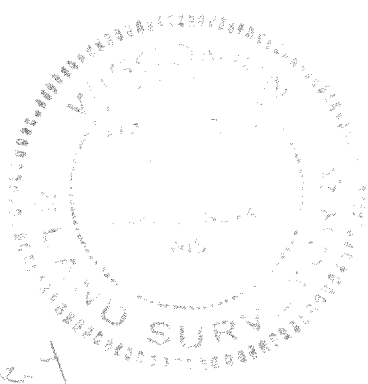

2A 2-1

7-544