


# HAROLD H. KOLB

REGISTERED PROFESSIONAL LAND SURVEYOR  
LAKE GENEVA, WISCONSIN

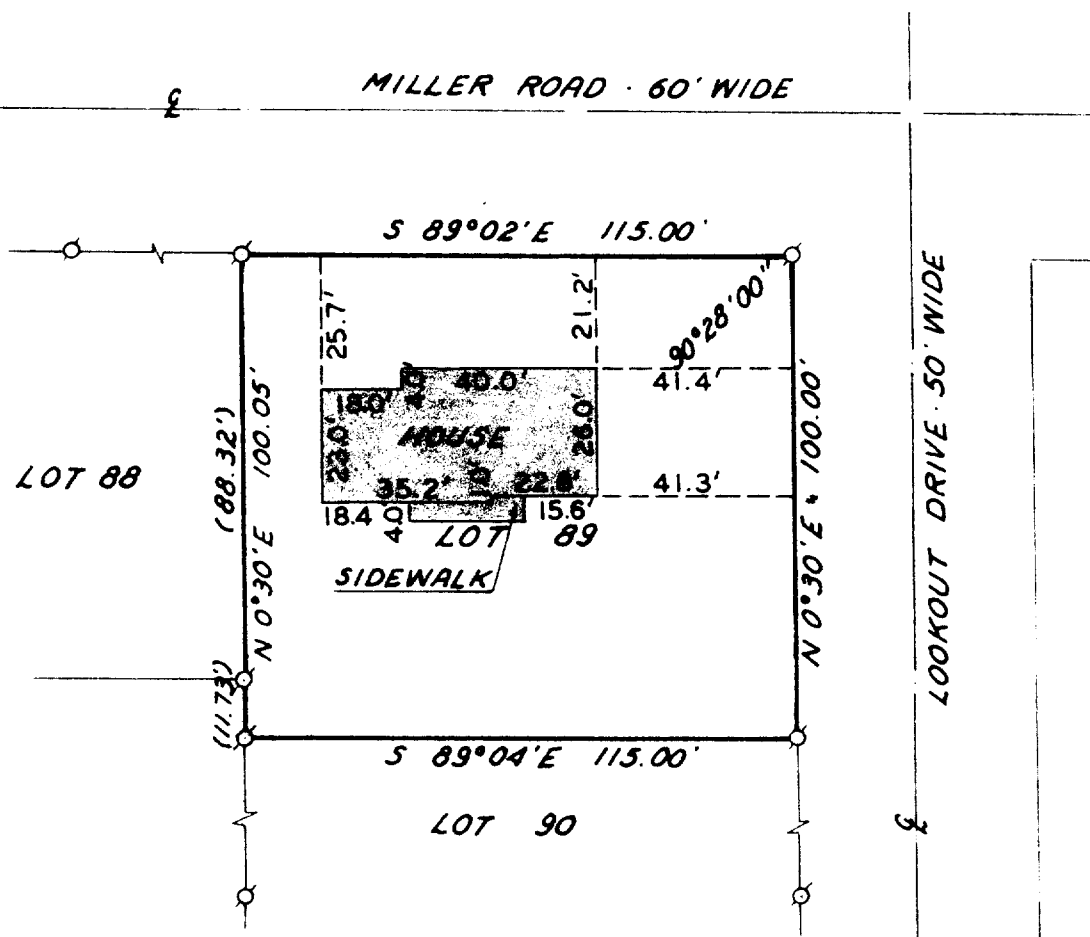

## PLAT OF SURVEY OF

LOT 89, STURWOOD ADDITION NO. 3, CITY OF  
LAKE GENEVA, WALWORTH COUNTY, WISCONSIN.

OWNER: HARRY BECKER

ACCURACY: DISTANCES:  $\pm 0.01'$   
ANGLES:  $\pm 65''$   
ERROR OF CLOSURE: LESS THAN ONE  
PART IN 3,000

N



SCALE: 1"=40'

### LEGEND

- φ — IRON PIPE FOUND
- — IRON PIPE PLACED
- — CONCRETE MONUMENT
- x — SPIKE
- ( ) — RECORDED AS

I, HAROLD H. KOLB, DO HEREBY CERTIFY THAT I HAVE  
SURVEYED THE PROPERTY HEREON DESCRIBED ACCORDING  
TO THE OFFICIAL RECORDS, AND THAT THE PLAT HEREON  
IS A CORRECT REPRESENTATION OF THE LOT LINES, AND  
THE PRINCIPLE BUILDING LINES THEREON.

*Harold H. Kolb*

HAROLD H. KOLB  
WISCONSIN REGISTERED LAND SURVEYOR, S-187  
DATE March 18, 1976



25T3-25

7-549-A