

# HAROLD H. KOLB


REGISTERED PROFESSIONAL LAND SURVEYOR  
LAKE GENEVA, WISCONSIN

STREET

PARK ROW

FRANKLIN COURT

MAXWELL

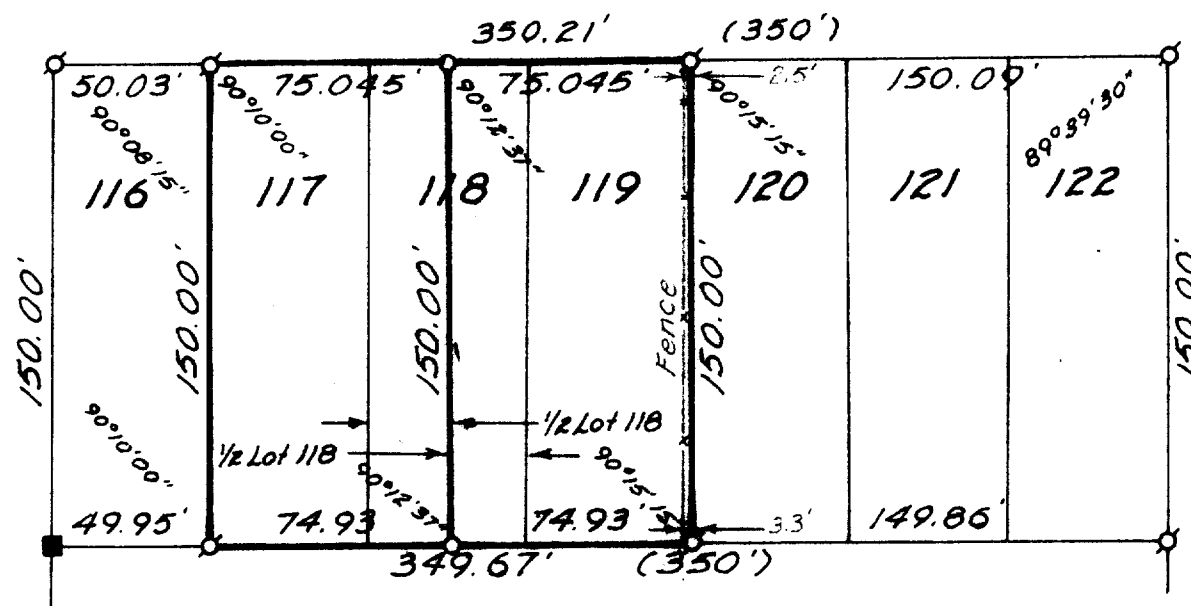

## PLAT OF SURVEY OF

LOT 117 AND THE WEST 1/2 OF LOT 118, COLUMBIAN  
SUBDIVISION; AND LOT 119 AND THE EAST 1/2 OF  
LOT 118, COLUMBIAN SUBDIVISION, ALL IN THE  
CITY OF LAKE GENEVA, WALWORTH COUNTY, WISCONSIN.

ORDERED BY: HAROLD H. KOLB

ACCURACY: DISTANCES  $\pm 0.01'$

ANGLES  $\pm 0^{\circ}00'05''$

ERROR OF CLOSURE-- LESS THAN ONE PART  
IN 3000.

N



SCALE: 1" = 60'

### LEGEND

- φ - IRON PIPE FOUND
- - IRON PIPE PLACED
- - CONCRETE MONUMENT FOUND
- ( ) - AS PLATTED



I, HAROLD H. KOLB, DO HEREBY CERTIFY THAT I HAVE  
SURVEYED THE PROPERTY HEREON DESCRIBED ACCORDING  
TO THE OFFICIAL RECORDS, AND THAT THE PLAT HEREON  
IS A CORRECT REPRESENTATION OF THE LOT LINES.

*Harold H. Kolb*

HAROLD H. KOLB

WISCONSIN REGISTERED LAND SURVEYOR, S-187

DATE AUGUST 21, 1976

7-568