



HAROLD H. KOLB

REGISTERED PROFESSIONAL LAND SURVEYOR
LAKE GENEVA, WISCONSIN

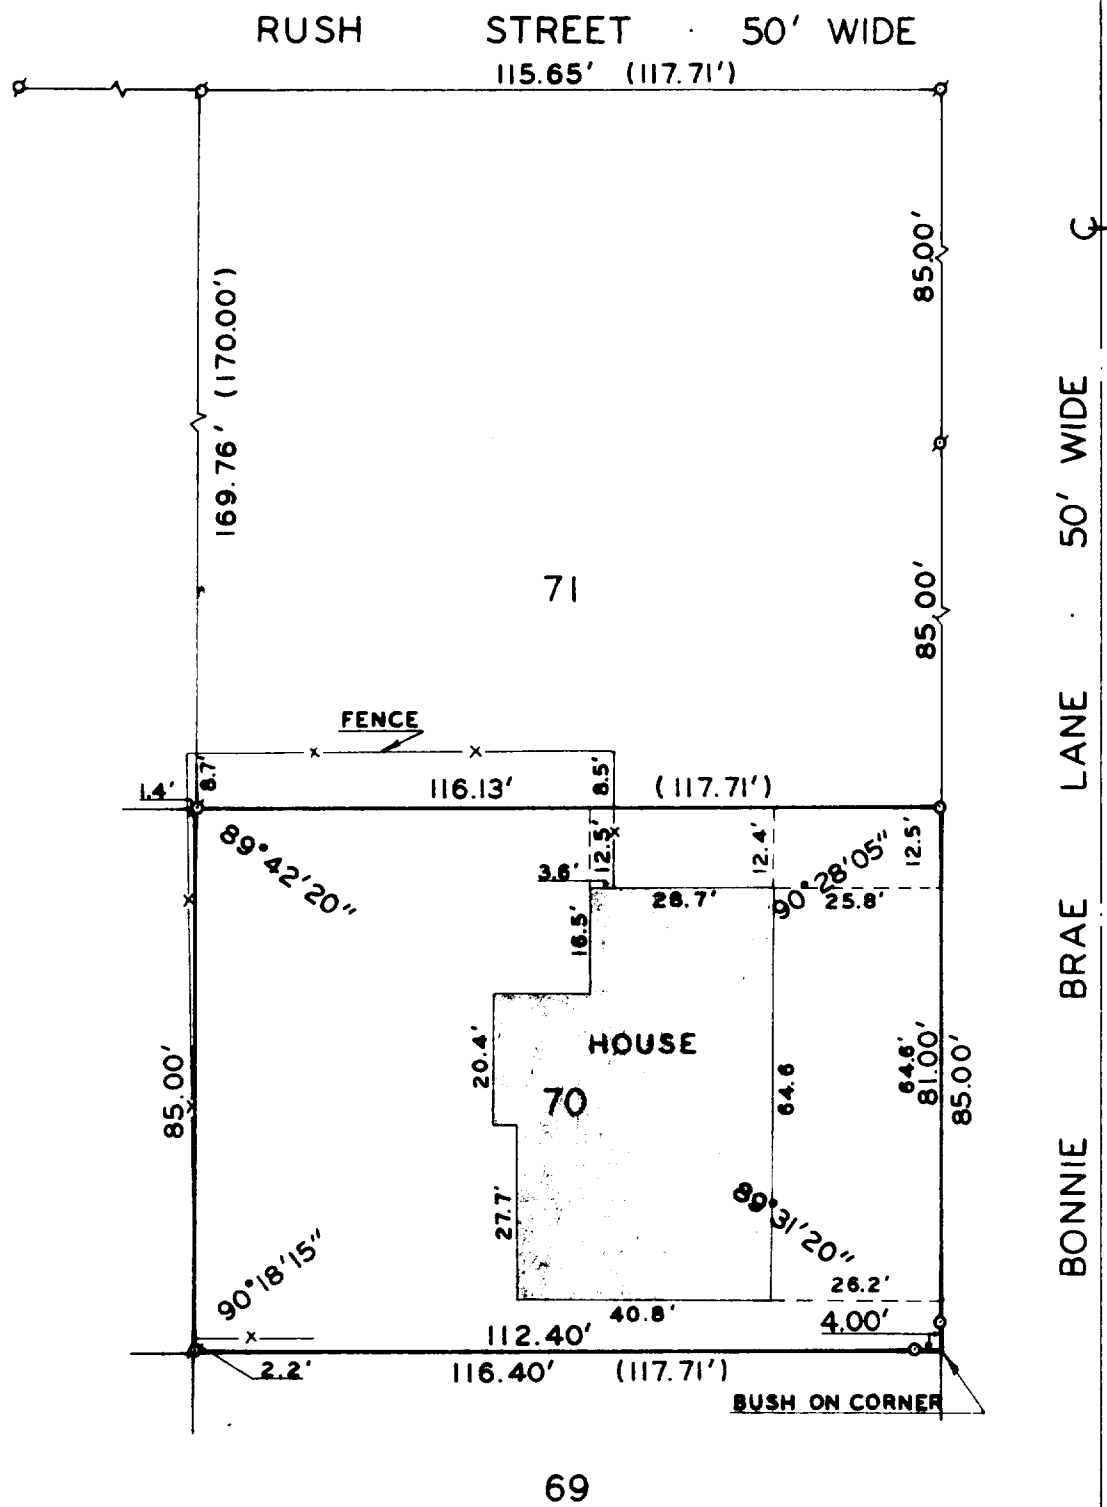

69 PLAT OF SURVEY OF

LOT 70, H.E. WELLS ADDITION, CITY OF
LAKE GENEVA, WALWORTH COUNTY, WISCONSIN.

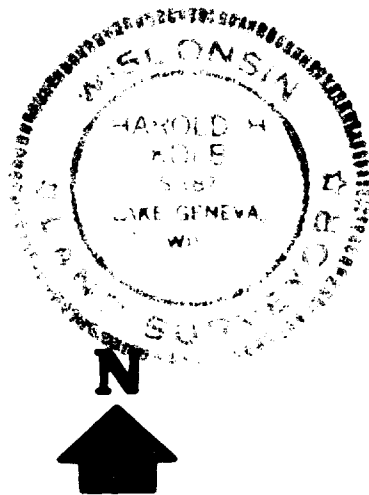

SCALE 1"=30'

LEGEND

- O — IRON PIPE PLACED. 1" x 24" 1.13 LB./LIN. FT.
- σ — IRON PIPE FOUND
- () — AS PLATTED

ORDERED BY:

ROBERT & MARY WRASE

ACCURACY: DISTANCES $\pm 0.01'$
ANGLES $\pm 05''$

ERROR OF CLOSURE--LESS THAN
ONE PART IN 3000

Harold H. Kolb

HAROLD H. KOLB
WISCONSIN REGISTERED LAND SURVEYOR, S-187
DATE March 25, 1977

7-595