


HAROLD H. KOLB

REGISTERED PROFESSIONAL LAND SURVEYOR
LAKE GENEVA, WISCONSIN

PLEASANT STREET

60' WIDE

66' WIDE
MADISON STREET

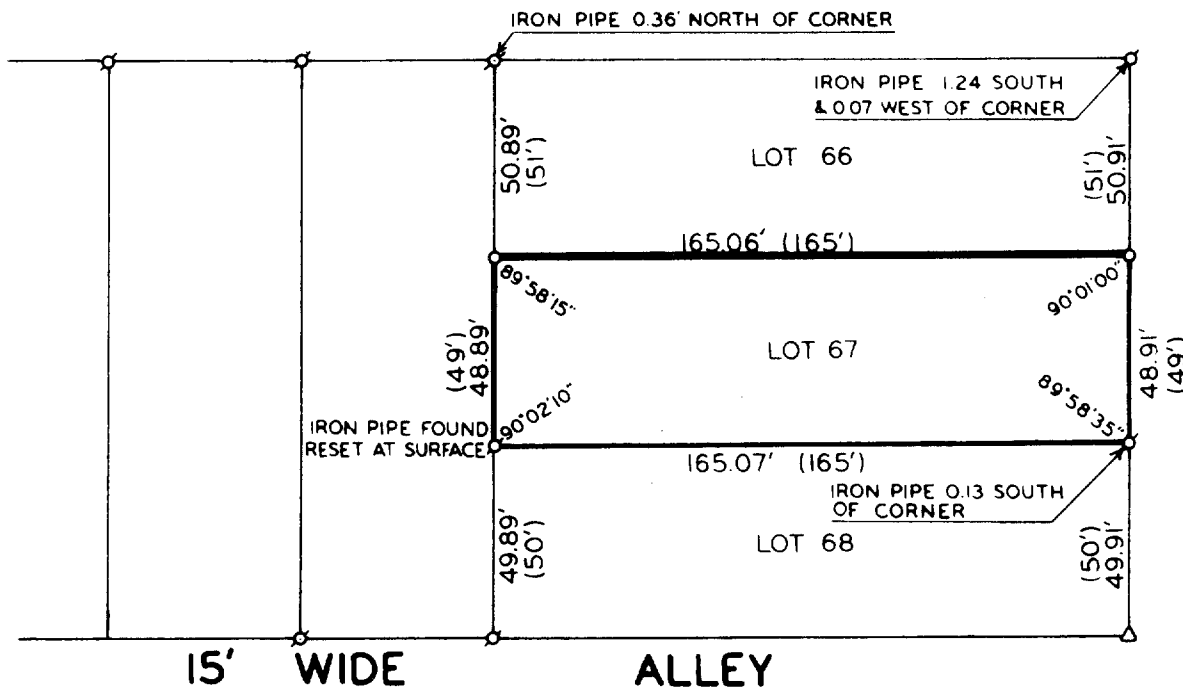

PLAT OF SURVEY OF

THE SOUTH 49 FEET OF LOT
67, COLUMBIAN SUBDIVISION,
CITY OF LAKE GENEVA,
WALWORTH COUNTY, WISCONSIN.

ORDERED BY: JIM O'BRIEN
LAKE GENEVA, WISCONSIN
53147



SCALE 1" = 50'

LEGEND

○ — IRON PIPE PLACED, 1" x 24" 1.13 LB./LIN. FT.

● — CONCRETE MONUMENT, 5" DIA. x 30"

△ — IRON ROD FOUND

○ — IRON PIPE FOUND

() — AS PLATTED

I, HAROLD H. KOLB, DO HEREBY CERTIFY THAT I HAVE
SURVEYED THE PROPERTY HEREON DESCRIBED ACCORDING
TO THE OFFICIAL RECORDS, AND THAT THE PLAT HEREON
IS A CORRECT REPRESENTATION OF THE LOT LINES.

Harold H. Kolb
HAROLD H. KOLB
WISCONSIN REGISTERED LAND SURVEYOR, S-187

DATE *Feb 17, 1978*