



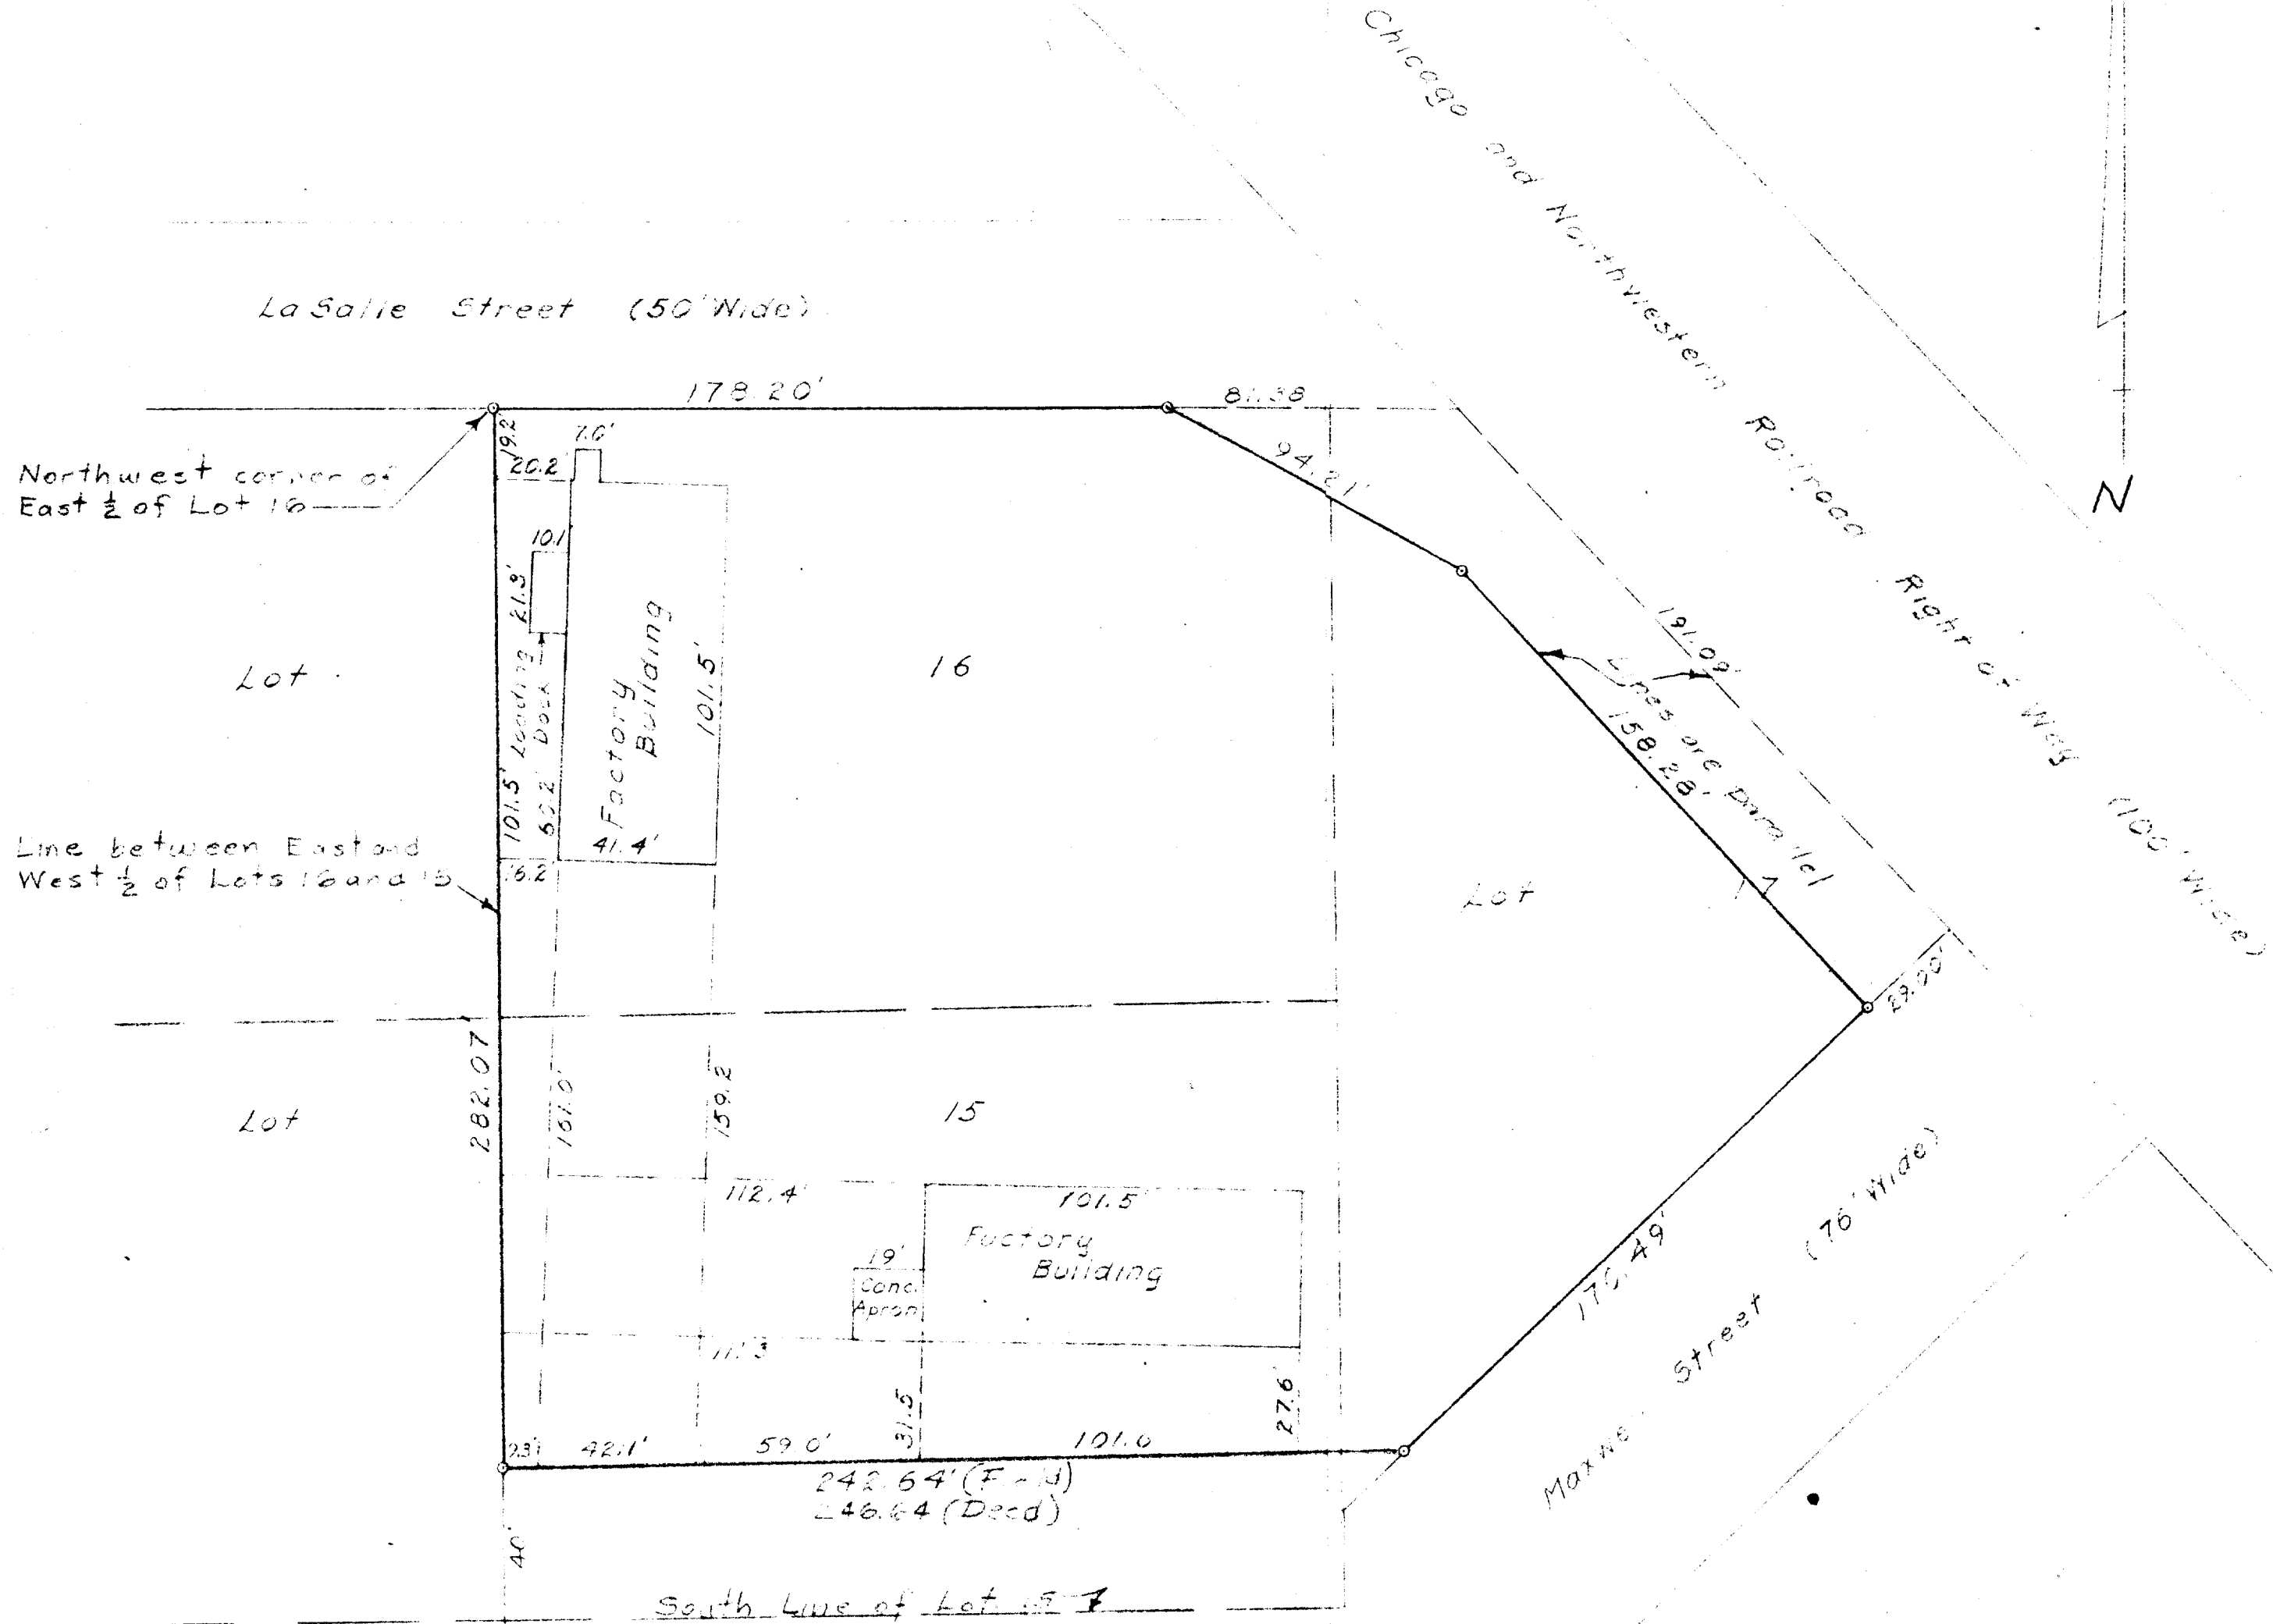

Legend
 • - Iron Pipe

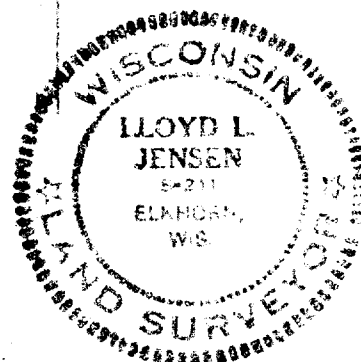

PLAT OF SURVEY OF

Part of Lots 15, 16 and 17, 2nd
 Columbian Subdivision, City of
 Lake Geneva, Walworth County,
 Wisconsin

Lloyd L. Jensen
 SURVEYOR

SCALE 1" = 40'

DATE July, 1960

CL2-14

7-65J