


PLAT OF SURVEY

No. 5156

Description : Lot 7 & 8, Block 18, Lake Geneva Manor, a Subdivision of part of the East $\frac{1}{2}$ of Section 35, Town 2, North, Range 17, East, of the Fourth Principle Meridian, Walworth County, Wisconsin.

SCALE 1" = 20'


O - DENOTES IRON STAKES

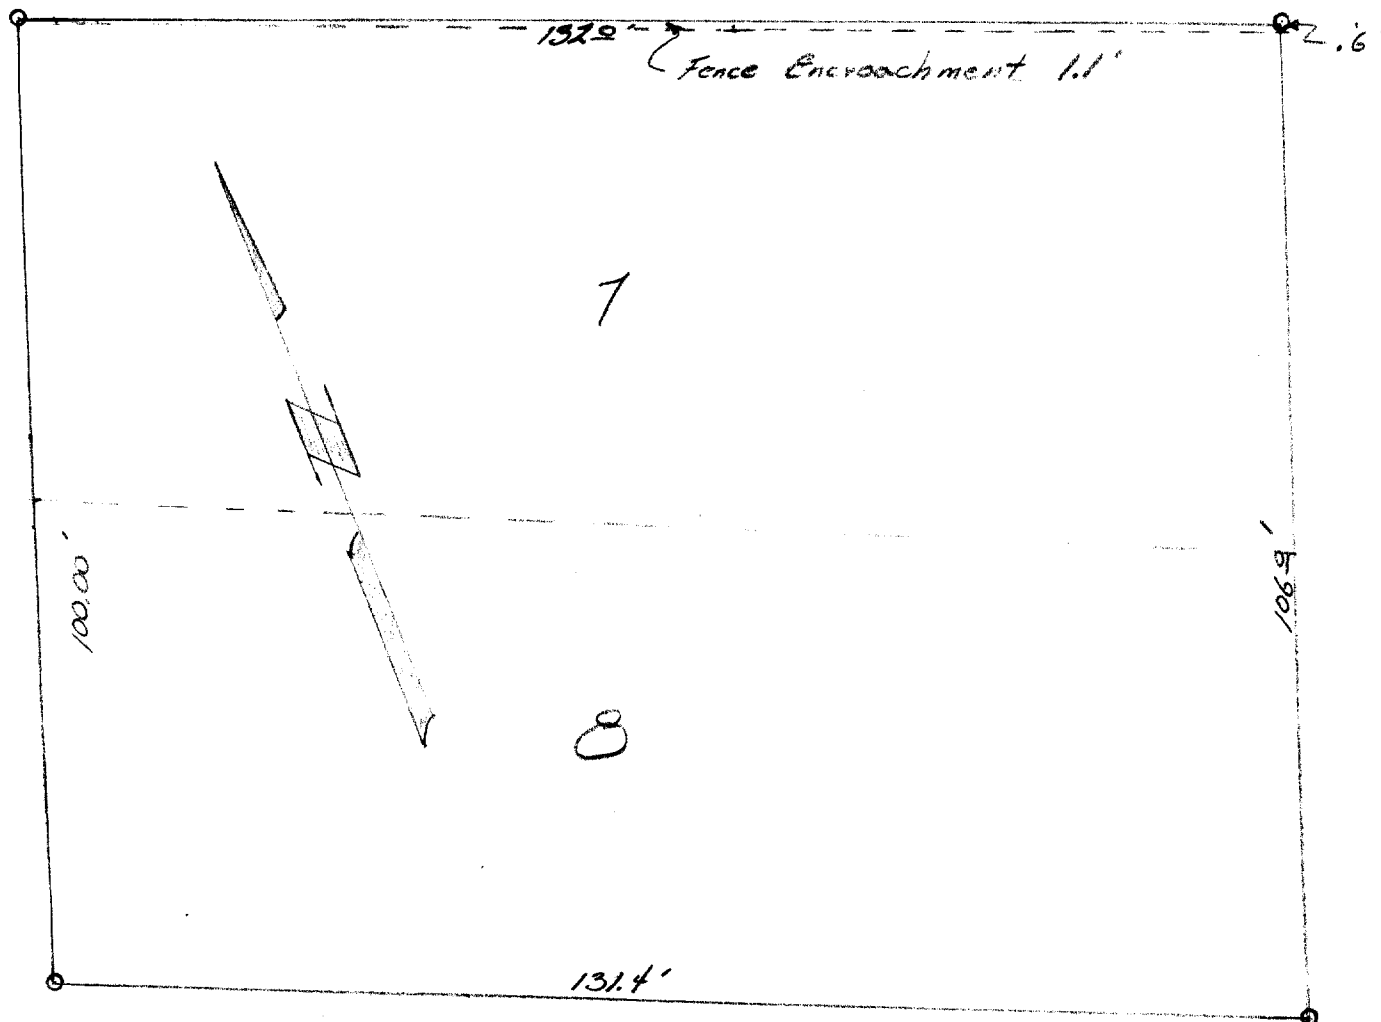

CERTIFICATE: I hereby certify that I have on this 15th day of May, 1966 surveyed the above described property at the request of the owner, and such encroachments do exist as shown.

Signed James F. Biasi
Surveyor

Signed James F. Biasi
Land Surveyor (No. 272)

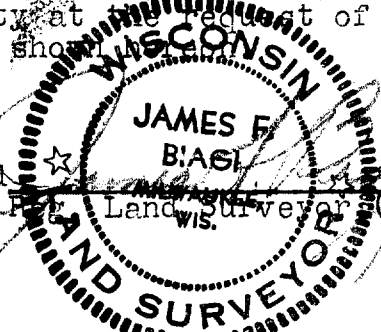

SIGNED AND SEALED THIS 15TH DAY OF MAY

7-66B