


FARRIS, HANSEN & COOPER, INC.

ENGINEERING, SURVEYING AND LAND PLANNING
715 W. WALWORTH ST. - P.O. BOX 487 - ELKHORN, WI 53121
OFFICE: 414/723-2098

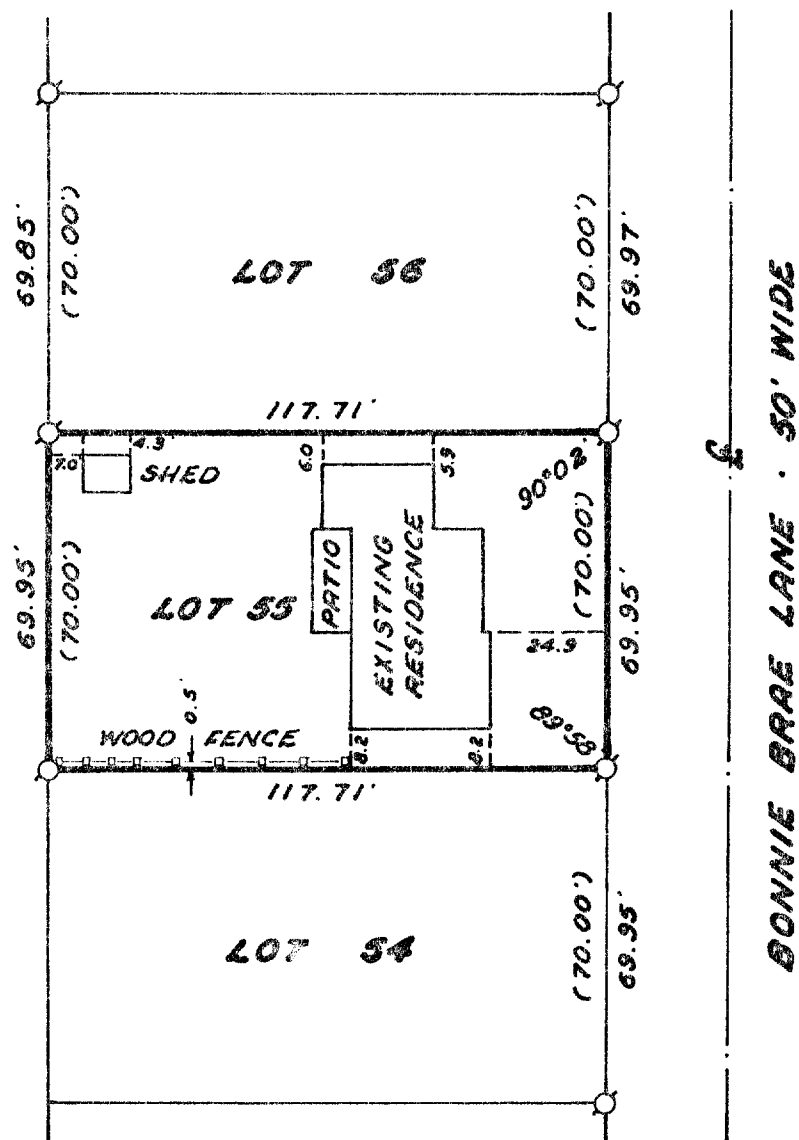

LEGEND

- Iron Pipe Found
- ()—Record Dimension

0 10 20 40
SCALE IN FEET
1"=40'


PLAT OF SURVEY OF

Lot 55, H. E. Wells Addition
to the City of Lake Geneva,
Walworth County, Wisconsin.

ORDERED BY: Jackie Rust--
Wauwatosa Realty

OWNER: Mr./Mrs. Glenn Barter
1142 Bonnie Brae Lane
Lake Geneva, WI 53147

BUYER: Dr. Richard and Mary
White

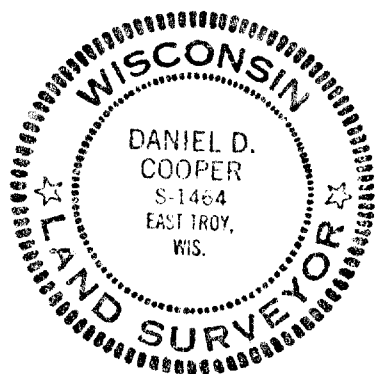

I HEREBY CERTIFY that I have surveyed the property described hereon and that this Plat of Survey is a true and accurate representation of the lot lines and the buildings thereon to the best of my professional knowledge and belief.

Daniel D. Cooper
Daniel D. Cooper, Wis. Reg. Surveyor, S-1464

8th May 1979
Date

PROJECT NO. 1514

7-677 F