
but 2 in Block 25 of Geneva Lake Crawford Manufacturing Company's Addition to the City of Lake Geneva, Walworth County, Wisconsin, according to the plat thereof recorded in the office of the Register of Deeds in and for said County of Walworth and State of Wisconsin.

\$T--- 66' wide — CENTER Survey for:

Great American Funding Corp.

Buyer: Edward & Janet Hall

Bearings hereon refer to the centerline of Center street as assumed North for mapping purposes.

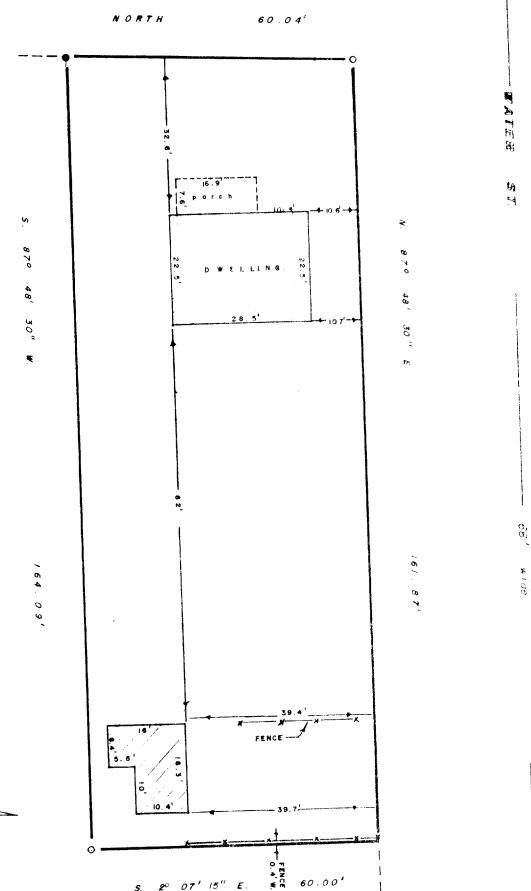

SCALE 1" = 20"

ROBERT L.

STERNBERG S-1361

SURY SURY

Denotes iron pipe found

🛪 Denotes existing fence

Denotes iron pipe set

I Certify that I have surveyed the described property and the above map is a true representation thereof and shows the size and location of the property, its exterior boundaries, the location and dimensions of all visible structures thereon, fences, apparent easements and roadways and visible encroachments, if any.

This survey is made for the exclusive use of present owners of property, and also those who purchase mortgage or guaranty the title thereto within one (1) year from date hereof.

79649