


PLAT OF SURVEY

LOTS 9 & 10, BLOCK 10
LAKE GENEVA MANOR SUBDIVISION
LOCATED IN THE CITY OF LAKE GENEVA
WALWORTH COUNTY, WISCONSIN

LAKE VIEW DRIVE

ORCHARD DRIVE

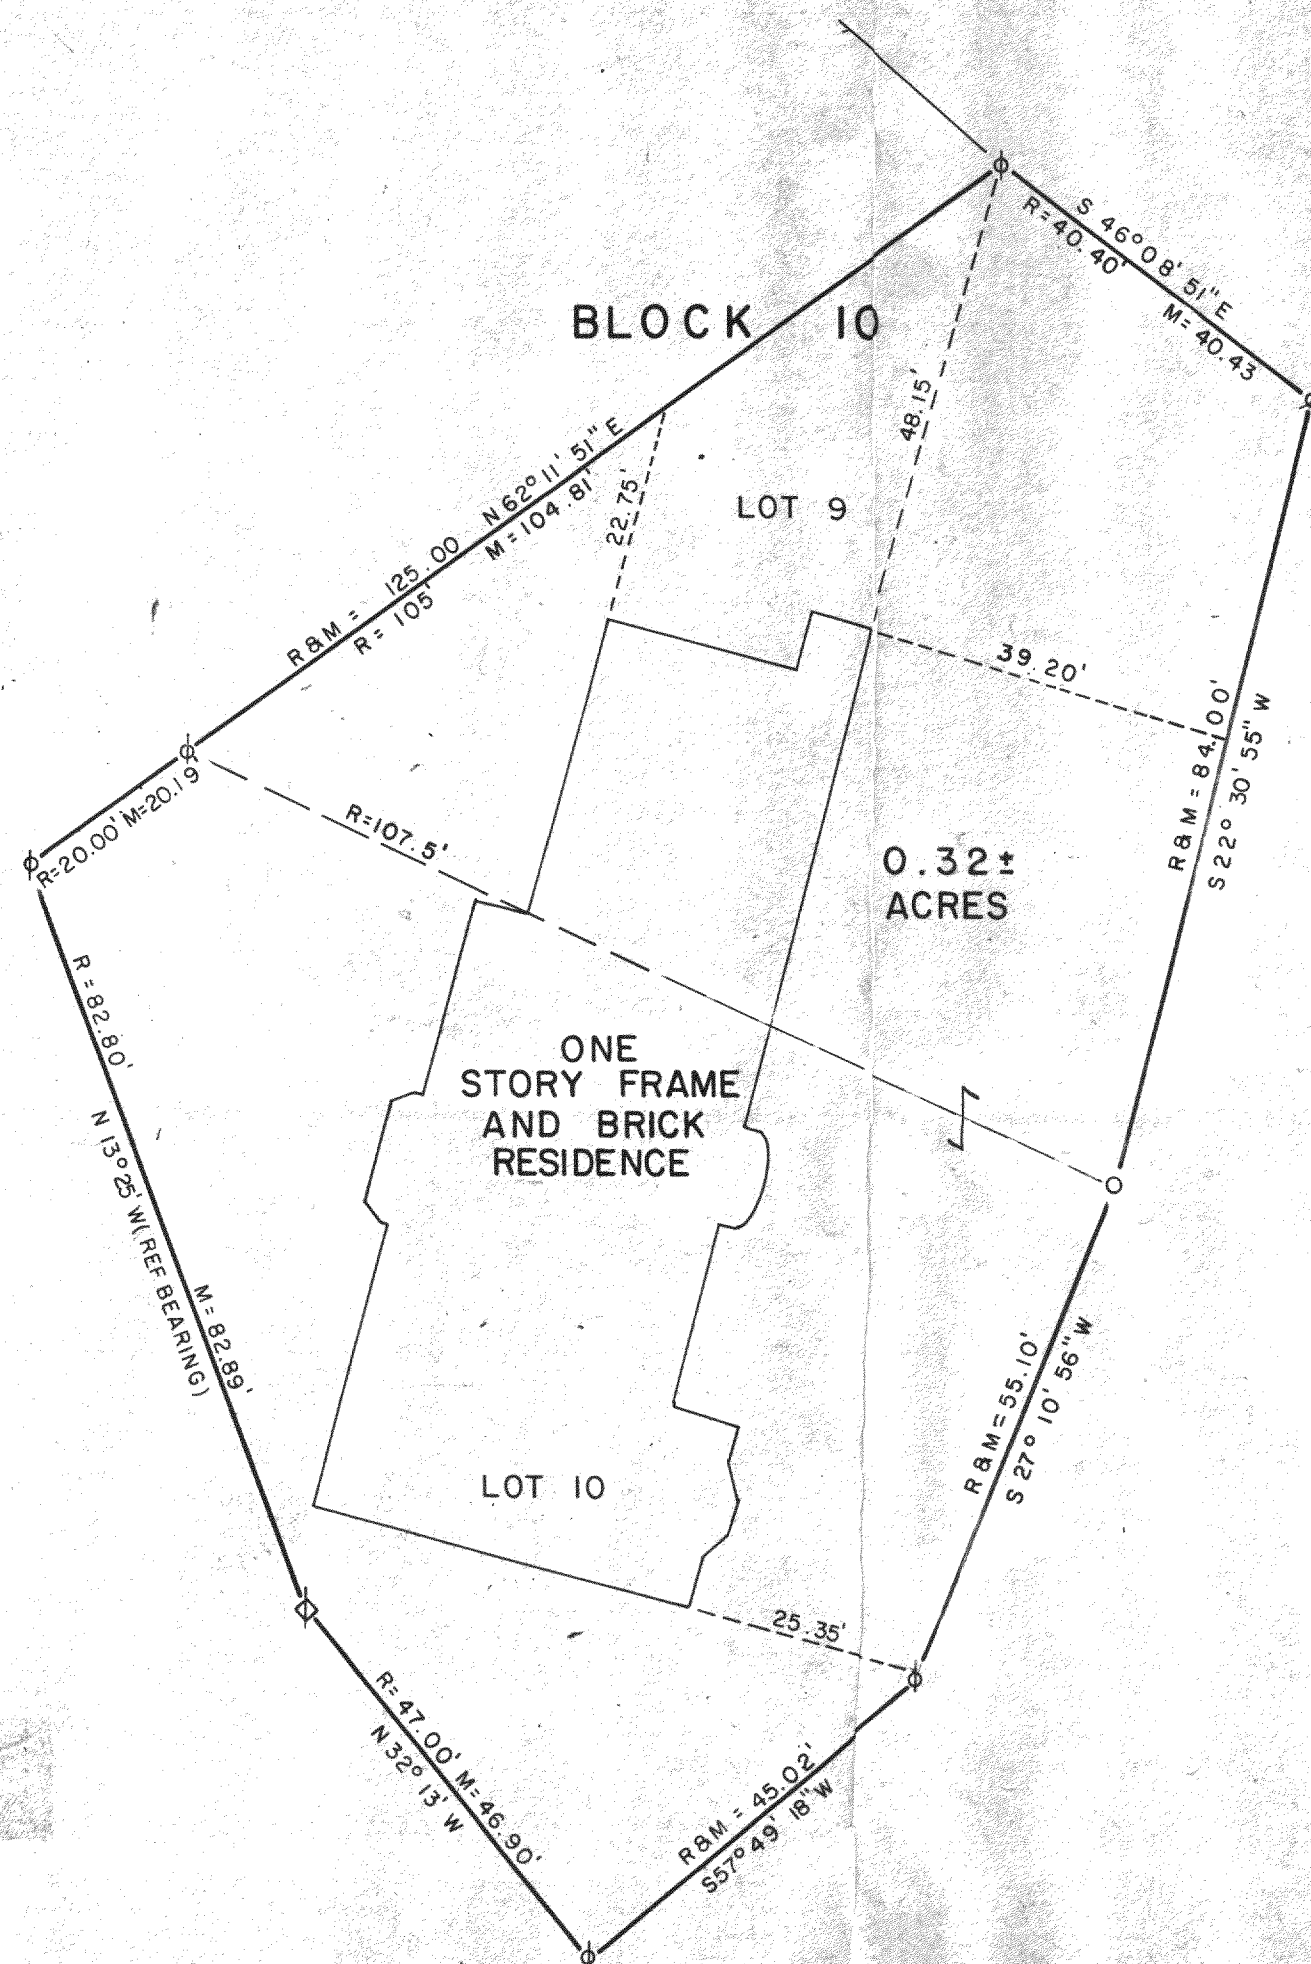

LEGEND

- Ø= FOUND IRON PIPE
- O= SET IRON PIPE
- ⊠= CONCRETE MONUMENT FOUND
- R= RECORDED
- M= MEASURED

DESCRIPTION:


lots nine (9) and ten (10) in Block ten (10), tract seventeen (17) of of Lake Geneva Manor, as shown on the plat thereof recorded in the office of the Register of Deeds in Vol. nine (9) of plats on Page fifty-two (52), Walworth County, Wisconsin.

Surveyors Certificate

I, Robert Scott Johnson, Registered Land Surveyor, do hereby certify that the plat shown hereon is a true and accurate survey and a true representation thereof and the exterior boundary lines and all divisions of said property have been surveyed under my direction and to the best of my knowledge and belief.

Dated This 24th day of APRIL, 1980


Robert Scott Johnson

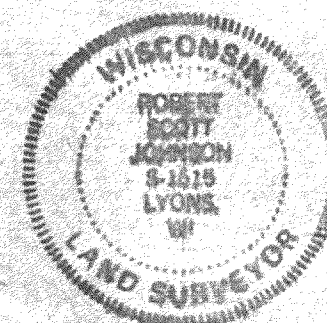

DATE APRIL 22, 1980

DRAWN BY *Dan Schauer*

CHECKED BY *D.E.J.*

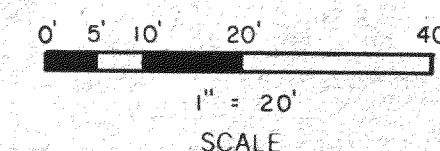

Surveyed for Abra Prentice Anderson 1972 Trust

NO. REVISIONS DATE

donohue & associates inc.

CONSULTANTS • ENGINEERS • PLANNERS • ARCHITECTS

ES-355
PROJECT NO. 10783.000
FILE NO.
SHEET NO. ONE