


KOLB LAND CONSULTING, INC.
LAND SURVEYING • SUBDIVIDING • LAND PLANNING


LAKE GENEVA, WISCONSIN 53147

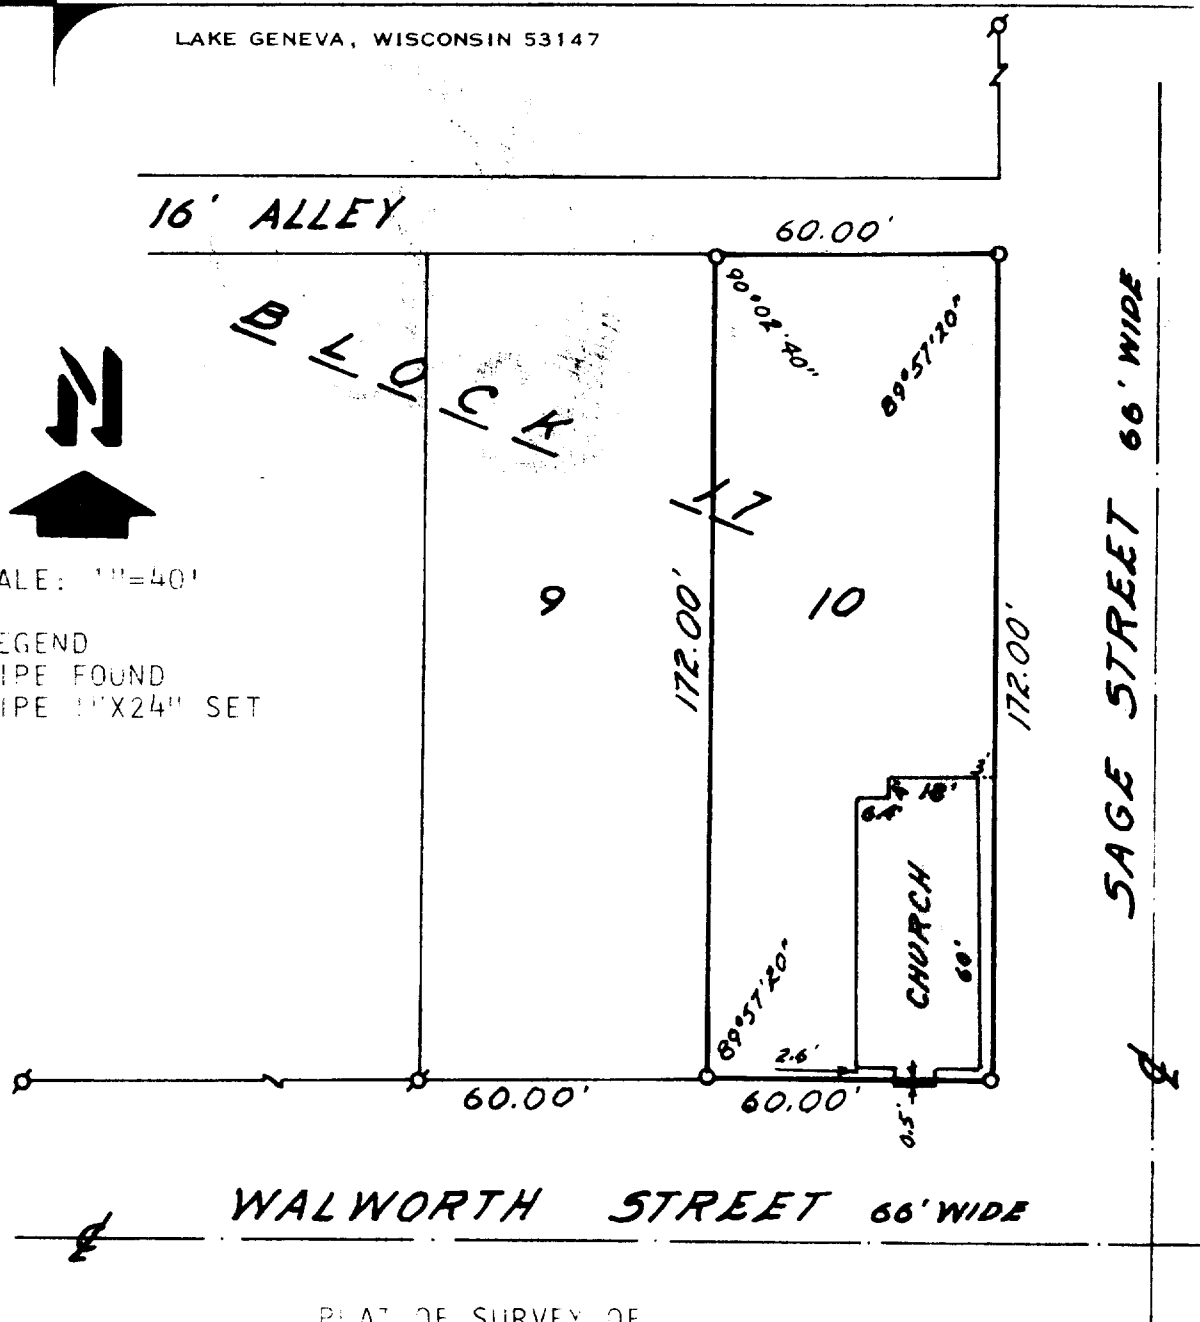

LEGEND
IRON PIPE FOUND
IRON PIPE 1"X24" SET

LOT 10, BLOCK 10, GENEVA LAKE CRAWFORD MANUFACTURING
COMPANY ADDITION TO THE CITY OF LAKE GENEVA, LOCATED IN
THE SOUTHEAST 1/4 OF SECTION 25, T 2 N, R 17 E, CITY OF
LAKE GENEVA, WALWORTH COUNTY, WISCONSIN.

ORDERED BY: STANLEY E. ENGSTROM
FOR: LAKE GENEVA BIBLE CHAPEL
601 WALWORTH STREET
LAKE GENEVA, WI. 53147

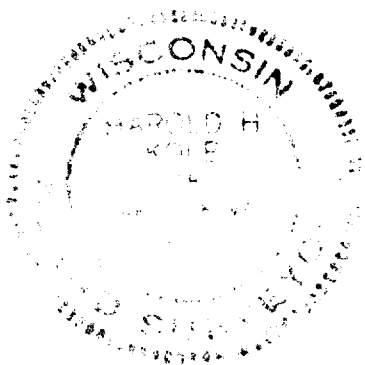

I, HAROLD H. KOLB DO HEREBY CERTIFY
THAT I HAVE SURVEYED THE PROPERTY
HEREON DESCRIBED ACCORDING TO THE
OFFICIAL RECORDS, AND THAT THE PLAT
HEREON IS A CORRECT REPRESENTATION
OF THE LOT LINES AND THE PRINCIPAL
LINES OF THE BUILDINGS THEREON TO
THE BEST OF MY KNOWLEDGE AND BELIEF.

Harold H. Kolb

WISCONSIN REGISTERED LAND SURVEYOR, S-187
DATE FEBRUARY 14, 1983