

LAKE GENEVA, WISCONSIN 53147

PEARSON DRIVE

50

88°07'

37.0'

37.0'

26.0'

22.3'

23.3'

0.4'

0.9'

0.3'

91°52'

91°52'

88°09'E

117.06'

117.06'

79.96'

HOUSE

DECK

28


29

CHAINLINK FENCE ENCROACHES

PLAT OF SURVEY OF

PLAT OF SURVEY OF

ORDERED BY: ROBERT PIERCE
297 PEARSON DRIVE
LAKE GENEVA, WI 53147

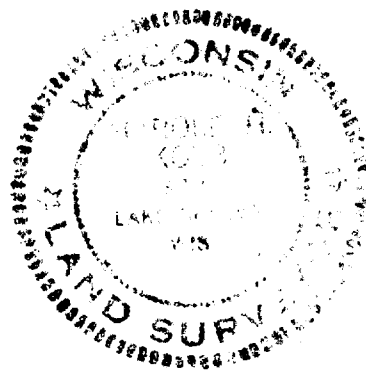

LEGEND

- I, HAROLD H. KOLB, DO HEREBY CERTIFY THAT I HAVE SURVEYED THE PROPERTY HEREON DESCRIBED ACCORDING TO THE OFFICIAL RECORDS, AND THAT THE PLAT HEREON IS A CORRECT REPRESENTATION OF THE LOT LINES TO THE BEST OF MY KNOWLEDGE AND BELIEF.

Harold H. Kell

HAROLD H. KOLB
WISCONSIN REGISTERED LAND SURVEYOR, S-187
DATE SEPTEMBER 28, 1983

ZP--00028

7-746