
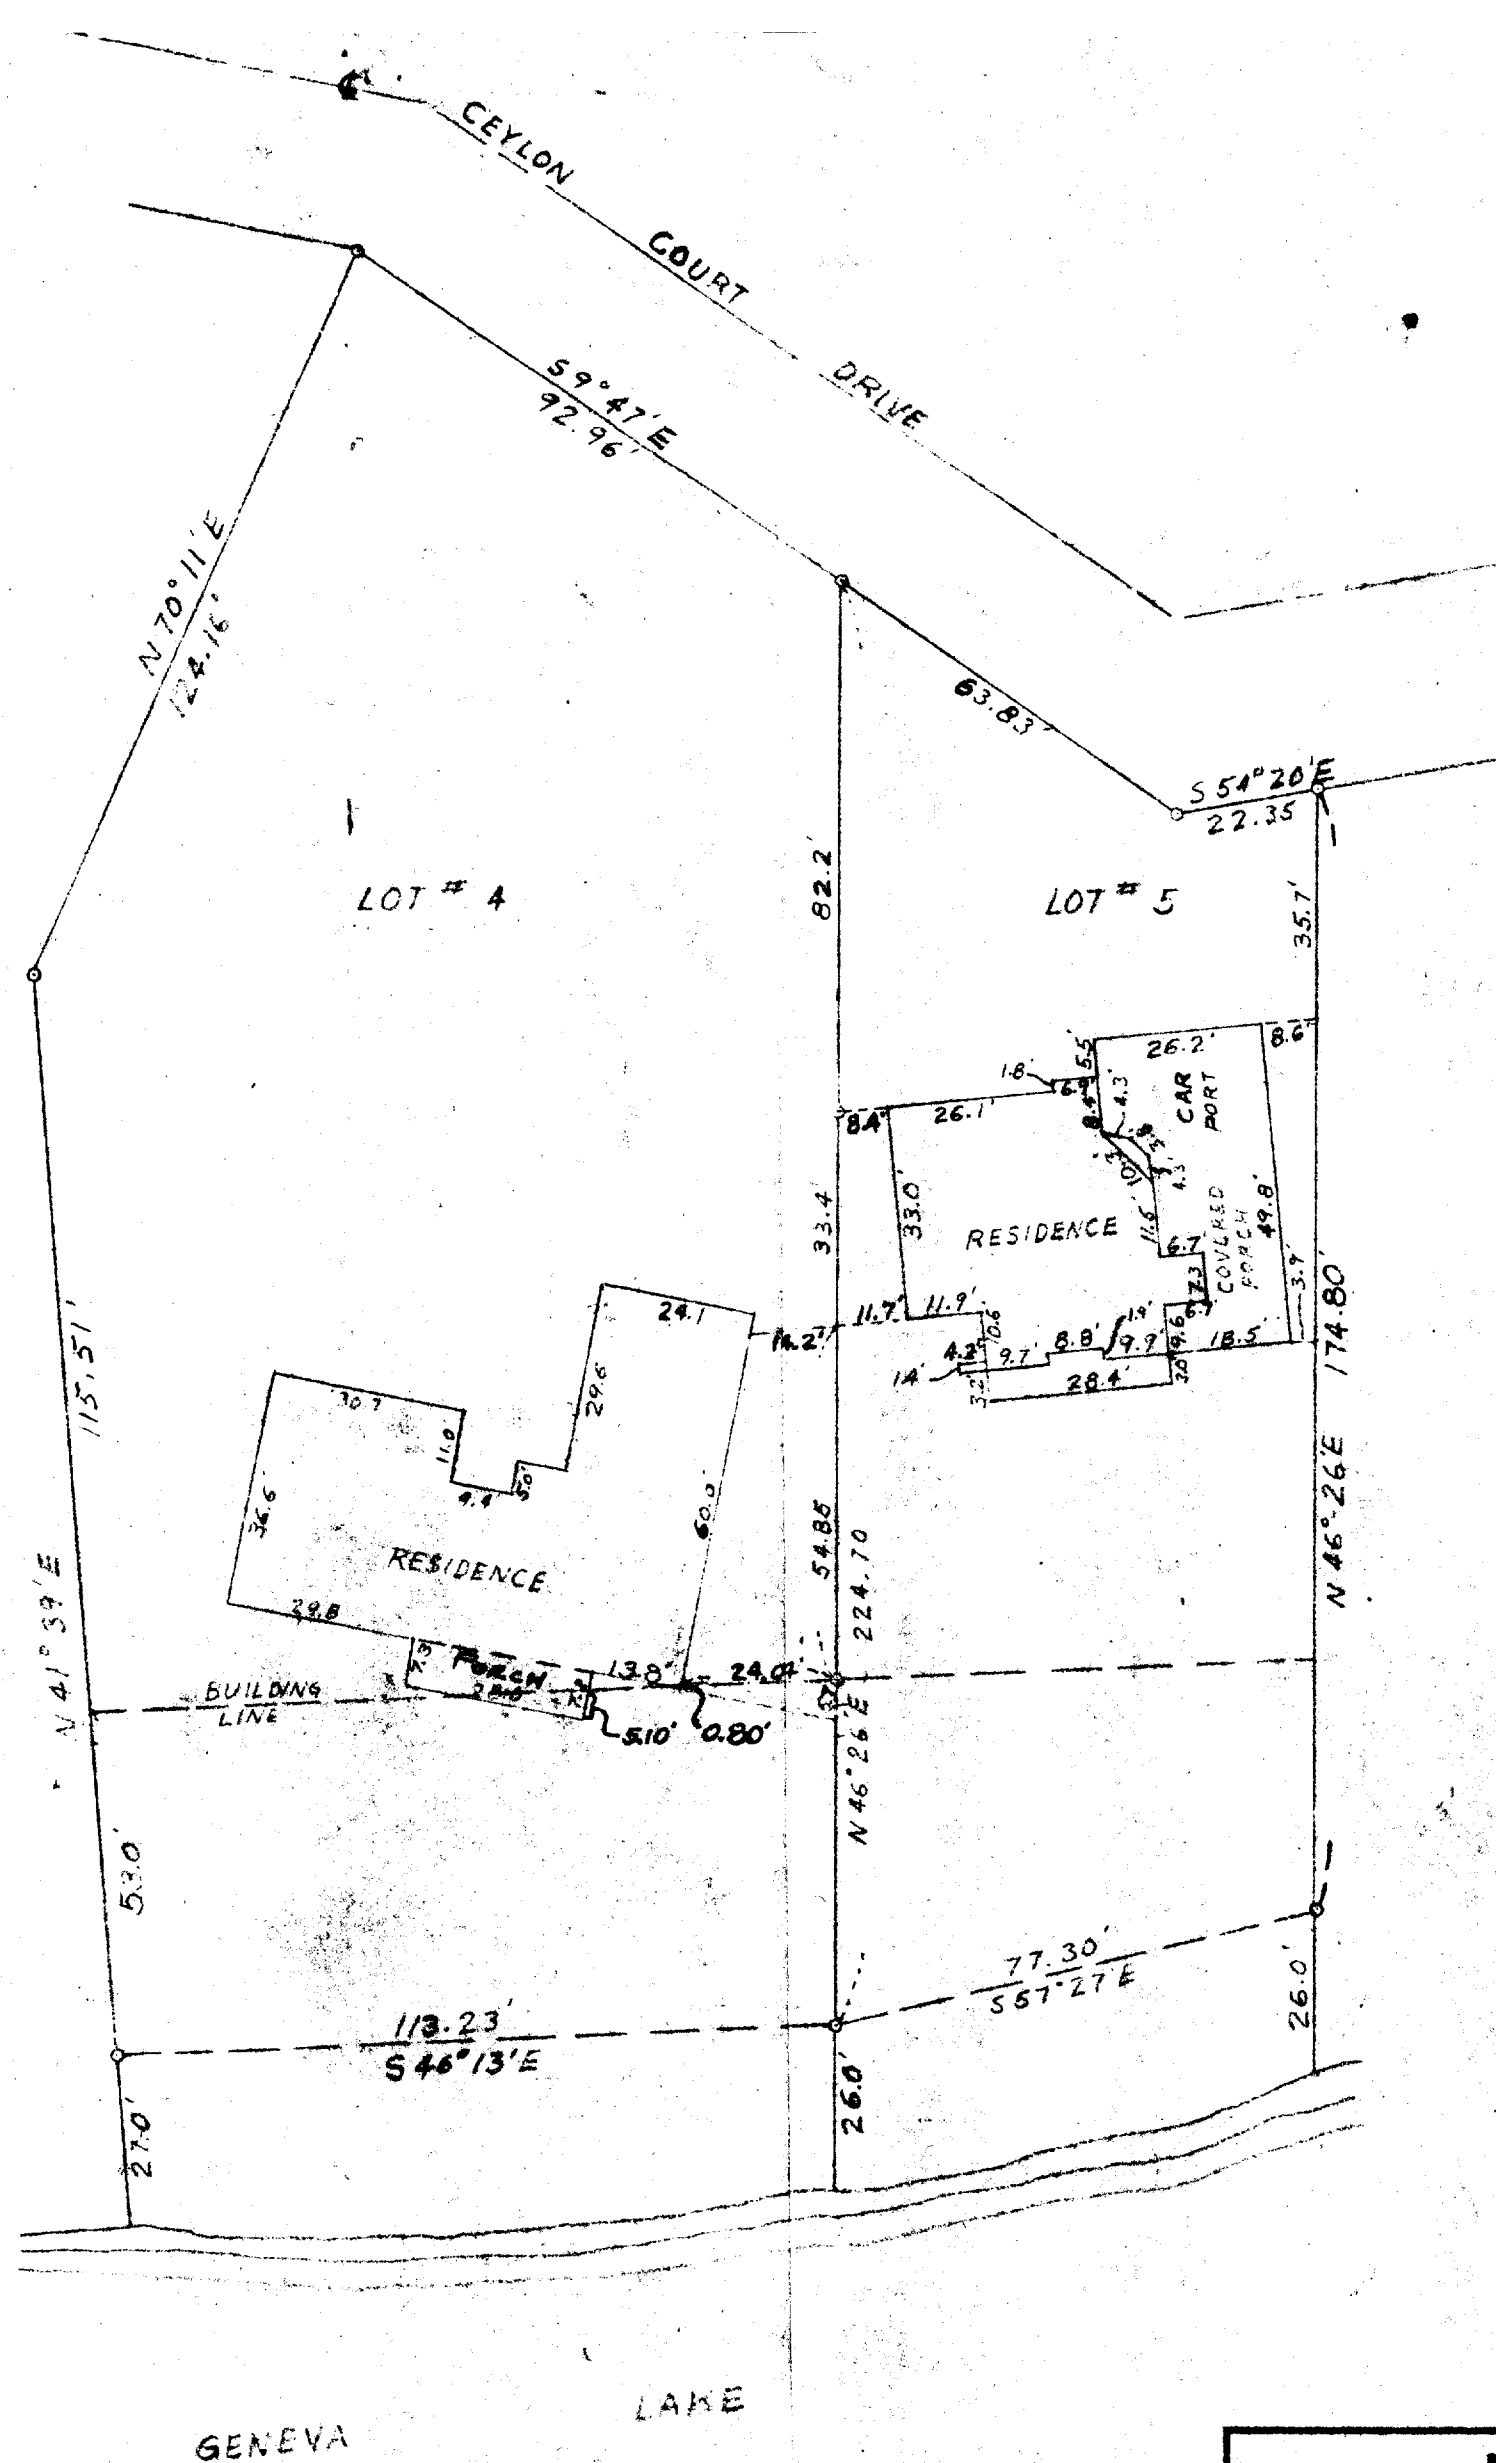


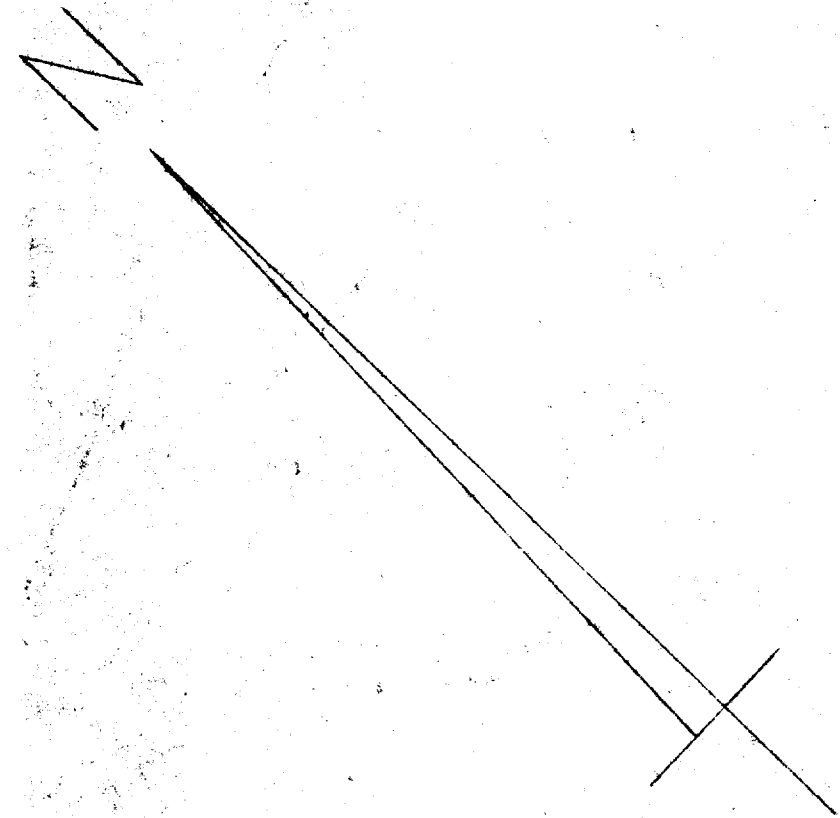

PLAT OF SURVEY
OF
LOTS #4 AND #5 CEYLON COURT
ESTATES, CITY OF LAKE GENEVA
WALWORTH COUNTY, WISCONSIN

Clough R. Jensen
SURVEYOR

DATE JULY 29 - 1959

SCALE 1" = 30'

7-74J

UP-141A + ZC-3