


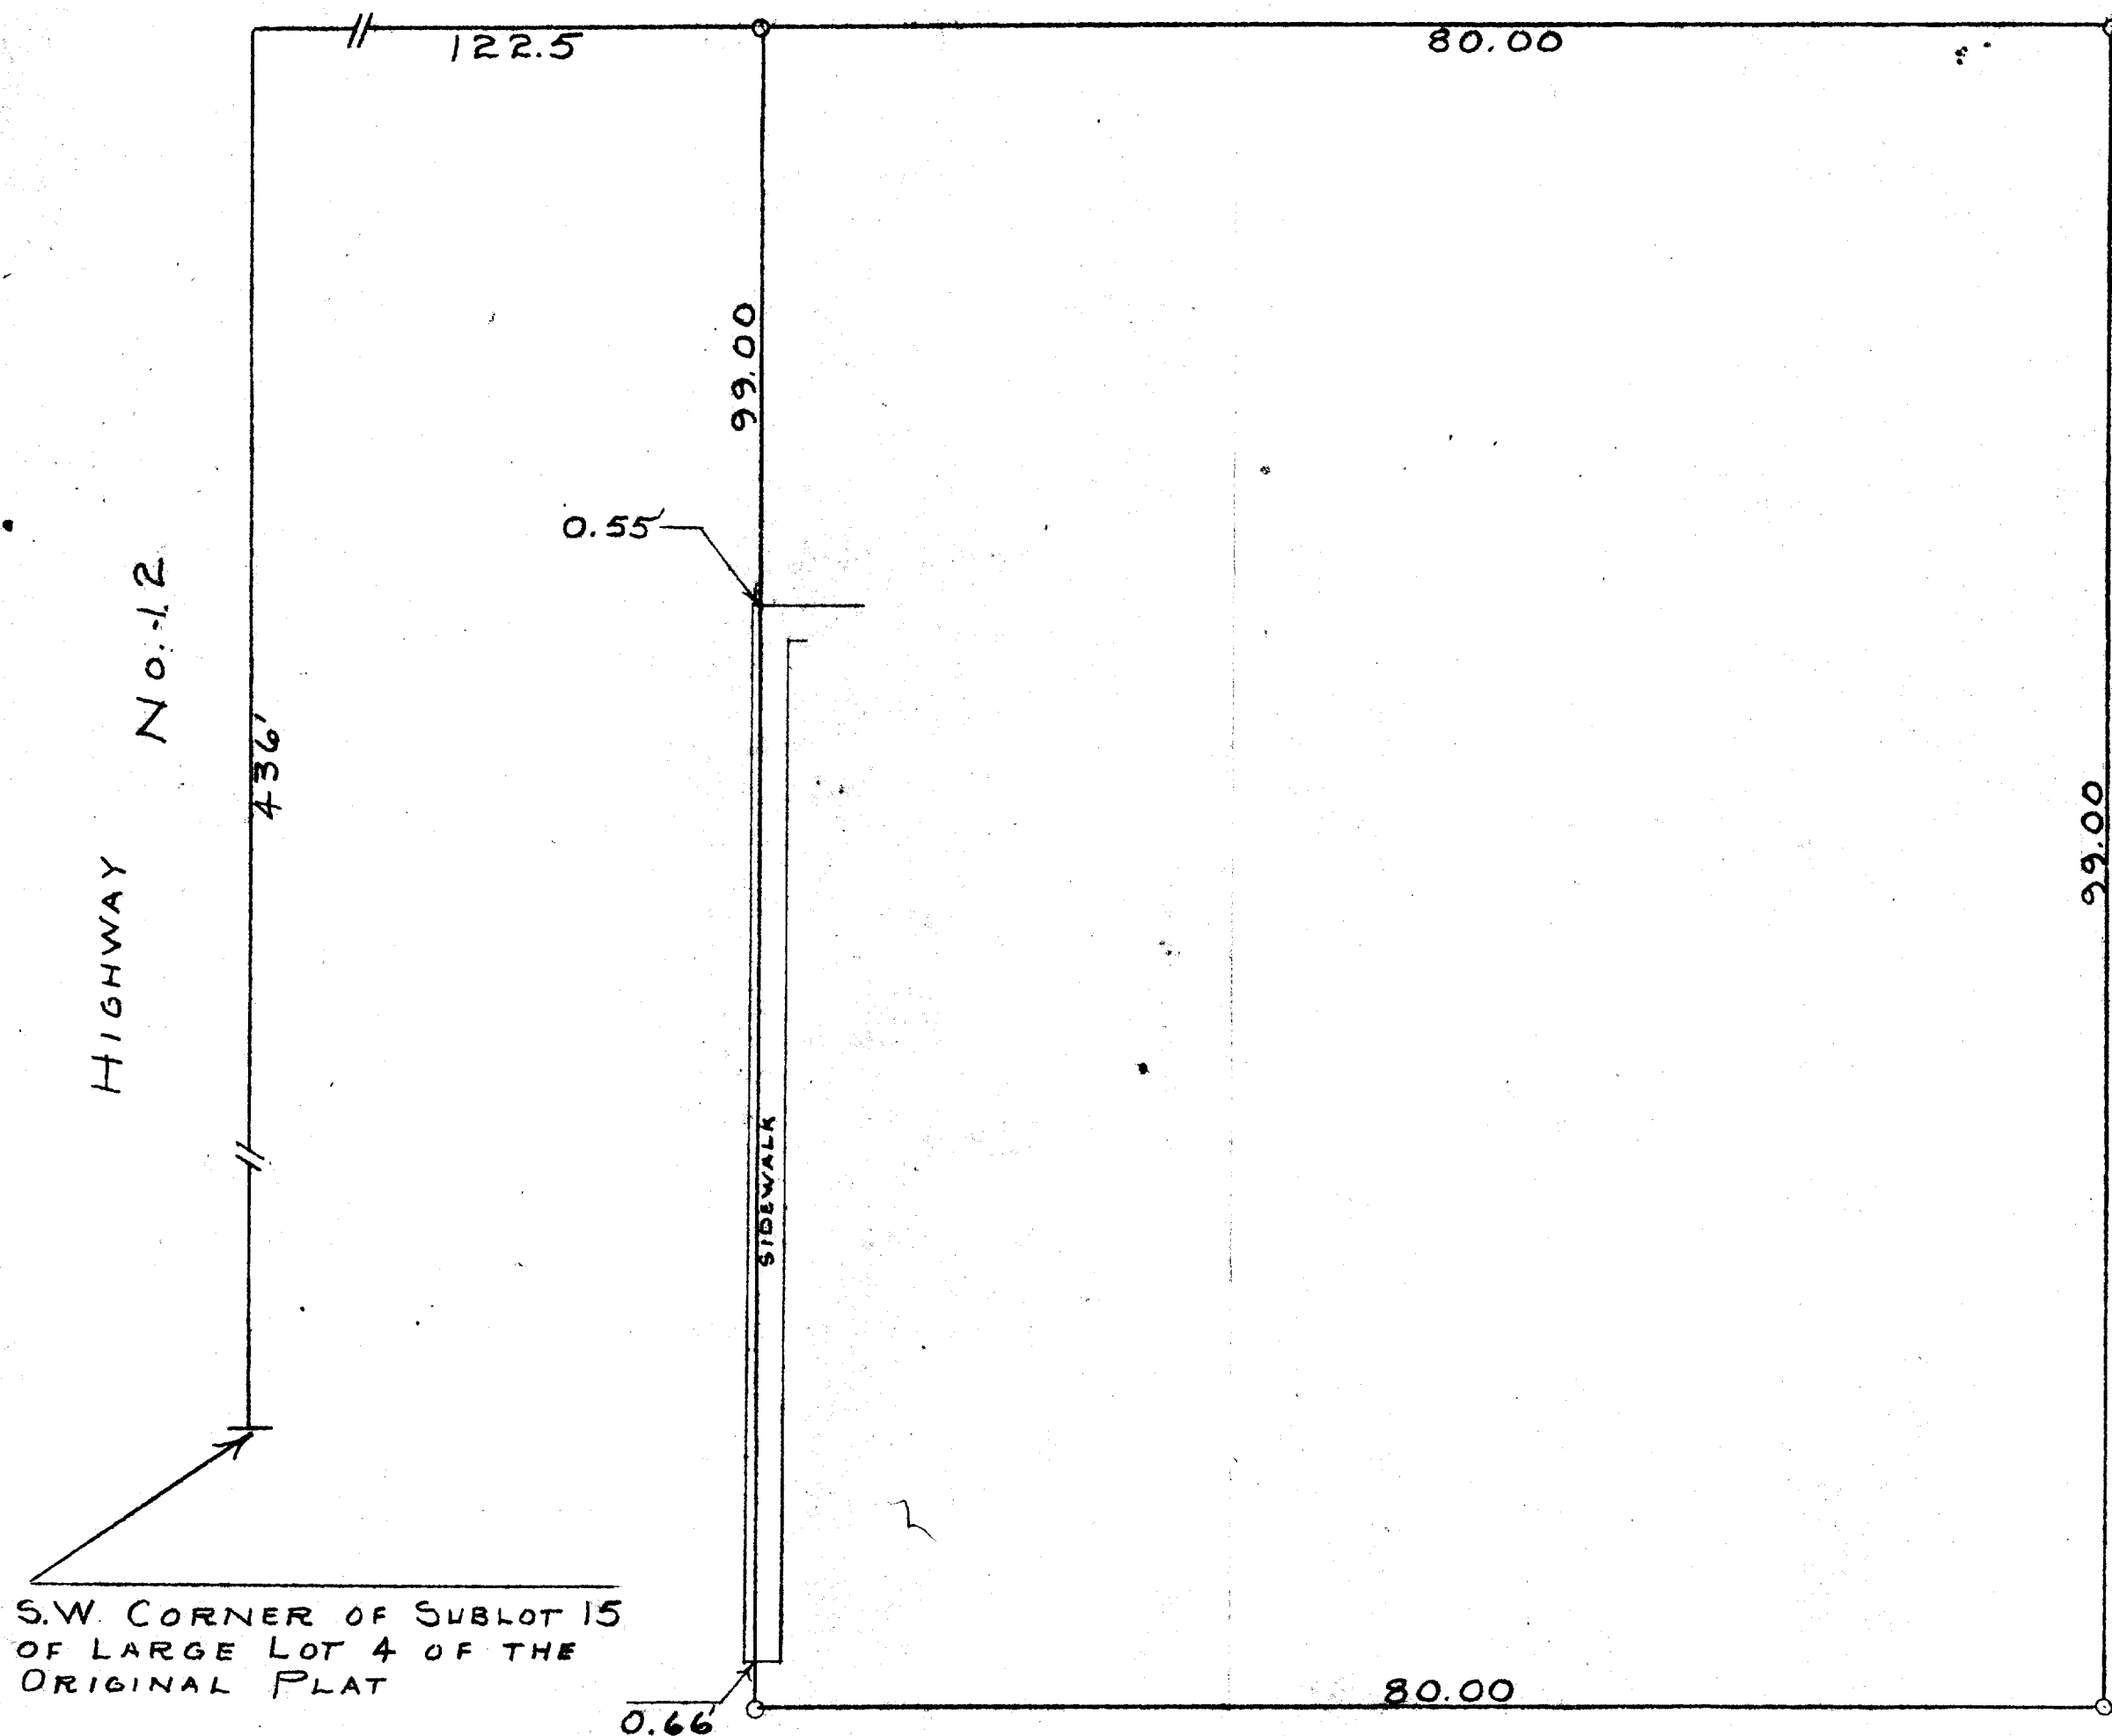

S.W. CORNER OF SUBLOT 15
OF LARGE LOT 4 OF THE
ORIGINAL PLAT

SCALE-1"=10'
O=IRON PIPE

PLAT OF SURVEY OF A PARCEL OF LAND DESCRIBED AS FOLLOWS:
COMMENCING AT THE S.W. CORNER OF SUBLOT 15 OF LARGE LOT 4 OF THE
ORIGINAL PLAT OF THE VILLAGE (NOW CITY OF LAKE GENEVA), WALWORTH
COUNTY, WISCONSIN; THENCE NORTH 436 FEET; THENCE EAST 122.5 FEET TO
THE PLACE OF BEGINNING; THENCE SOUTH 99.00 FEET; THENCE EAST 80.00
FEET; THENCE NORTH 99.00 FEET; THENCE WEST 80.00 FEET TO THE PLACE
OF BEGINNING
MAY 12, 1959

George T. Dunham
GEORGE T. DUNHAM, SURVEYOR
DELAWARE, WISCONSIN