


KOLB LAND CONSULTING, INC.
LAND SURVEYING • SUBDIVIDING • LAND PLANNING

LAKE GENEVA, WISCONSIN 53147

WHITEWATER, WISCONSIN 53190

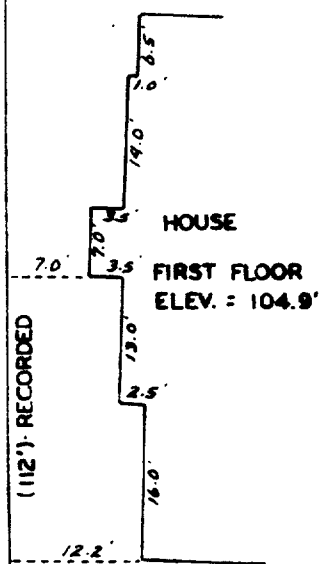

PLAT OF SURVEY OF

THE SOUTH 60.00 FEET OF LOT 6, BLOCK
10 OF THE ORIGINAL PLAT TO THE CITY
OF LAKE GENEVA, WALWORTH COUNTY,
WISCONSIN.

OWNER: RUSSELL PRICE
ROUTE 7, BOX 470
BURLINGTON, WI 53105


ORDERED BY: KEN CONELL
415 BROAD ST.
LAKE GENEVA, WI 53147

BLOCK

LOT 6

LOT 5

ZONED: R-2

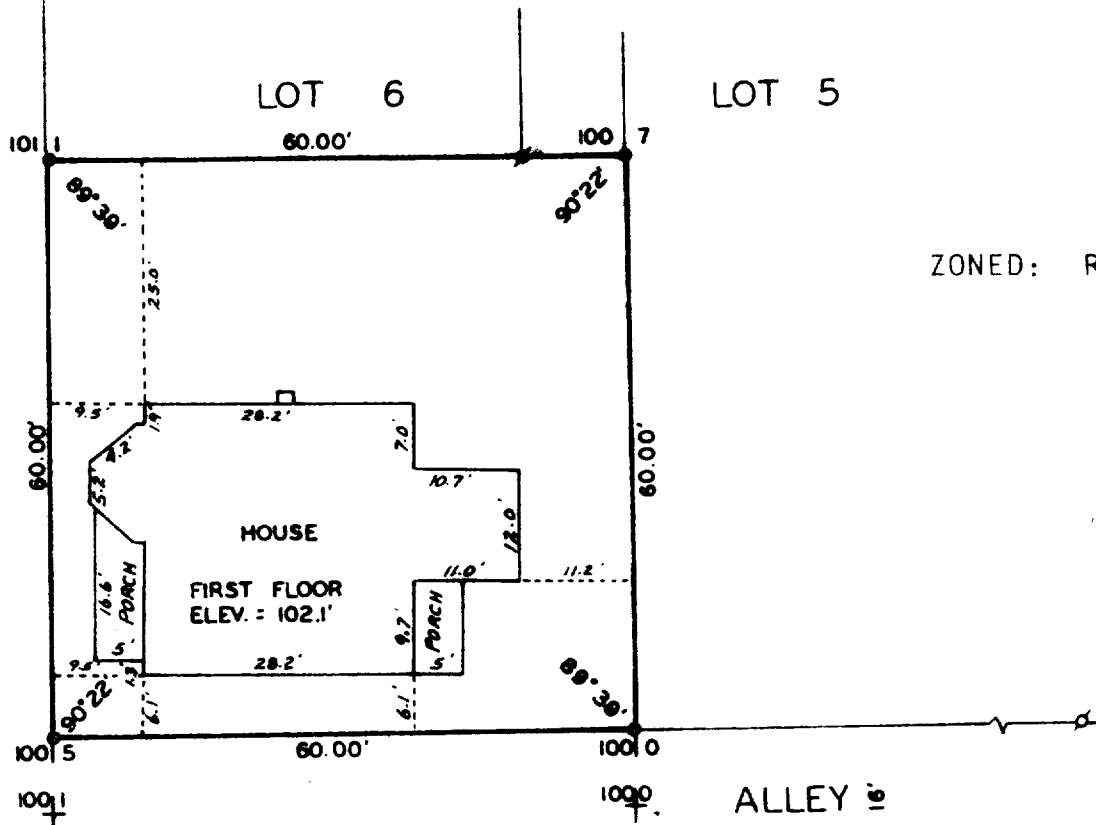

WARREN STREET


ALLEY



SCALE - 1"=20'

LEGEND

- o - IRON PIPE SET
- ELEVATION
- o - IRON PIPE FOUND

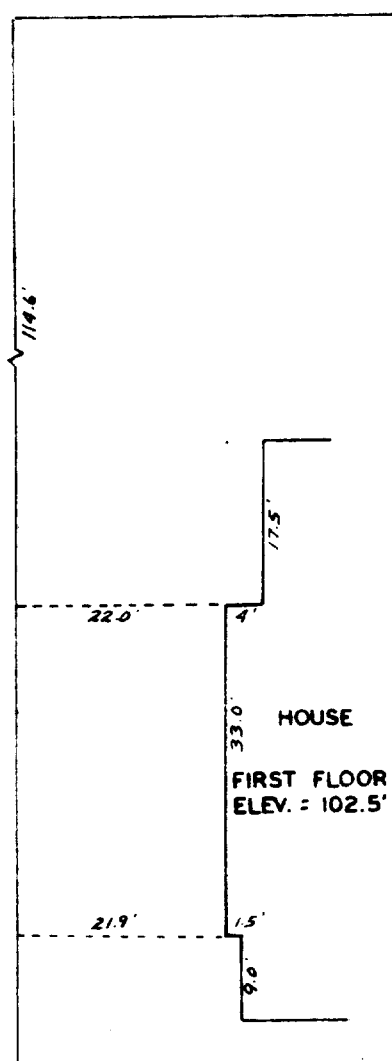

I, HAROLD H. KOLB, DO HEREBY CERTIFY
THAT I HAVE SURVEYED THE PROPERTY
HEREON DESCRIBED ACCORDING TO THE
OFFICIAL RECORDS, AND THAT THE PLAT
HEREON IS A CORRECT REPRESENTATION
OF THE LOT LINES TO THE BEST OF MY
KNOWLEDGE AND BELIEF.

Harold H. Kolb
HAROLD H. KOLB

WISCONSIN REGISTERED LAND SURVEYOR, S-187
DATE FEBRUARY 27, 1984

ZOP-79

7-770