



WALWORTH COUNTY
SURVEYING & MAPPING
LAKE GENEVA, WISCONSIN

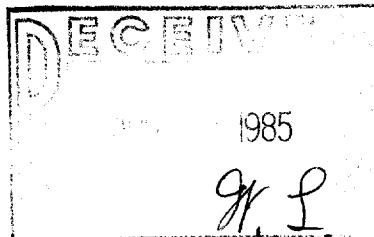


MAIN STREET

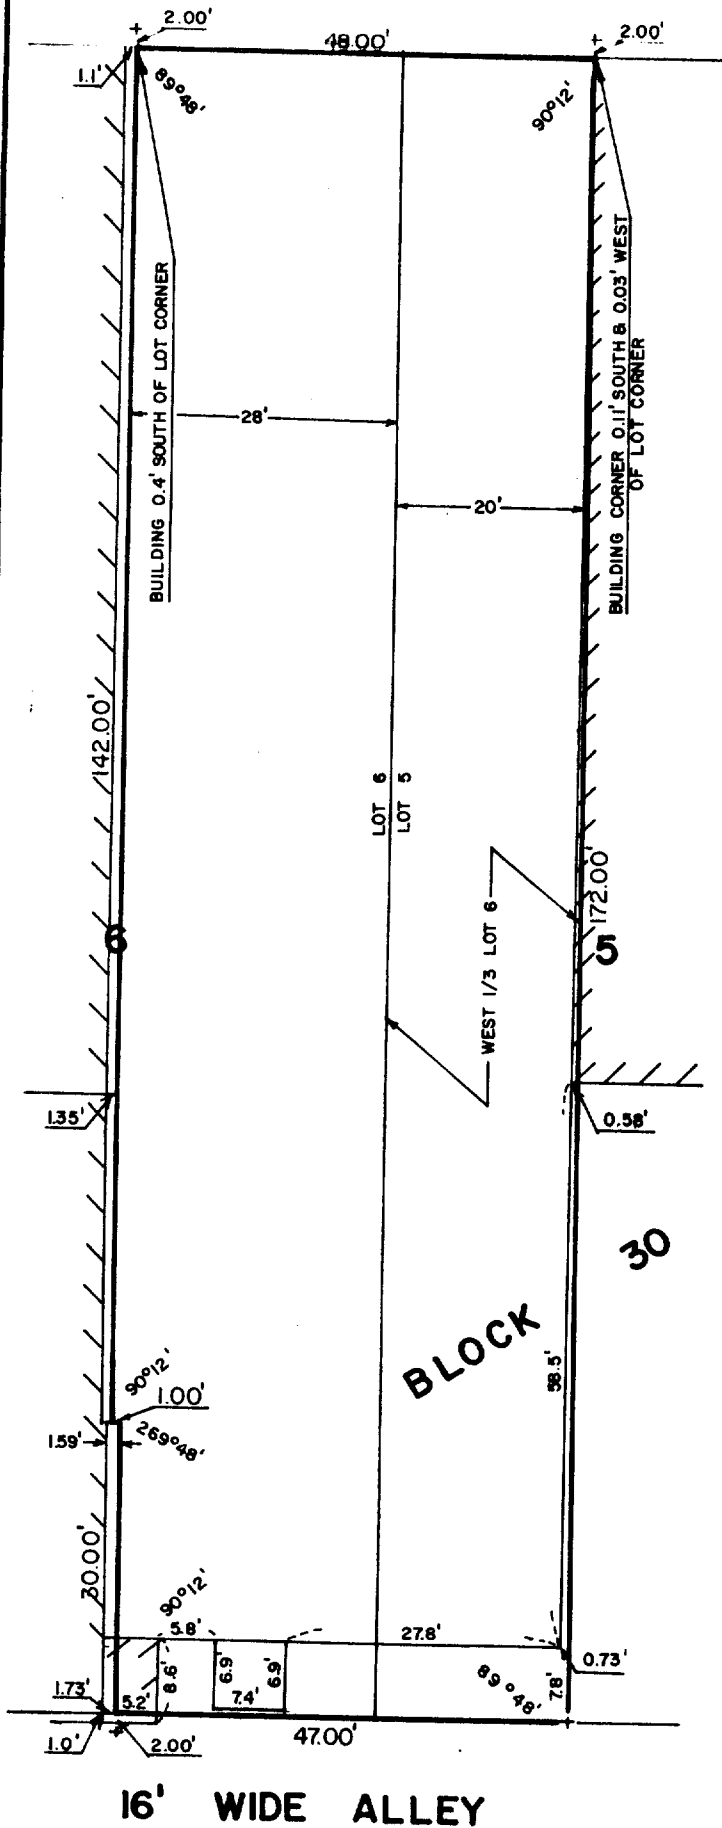

PLAT OF SURVEY OF

THE WEST 1/3 OF LOT 5 AND THE EAST
28 FEET OF LOT 6, EXCEPTING A STRIP
OF LAND 1 FOOT WIDE EAST AND WEST
AND 30 FEET LONG NORTH AND SOUTH OUT
OF THE SOUTHWEST CORNER OF SAID 28
FEET, ALL LOCATED IN BLOCK 30 OF THE
VILLAGE OF GENEVA, NOW CITY, WALWORTH
COUNTY, WISCONSIN.

ORDERED BY: KEEFE REAL ESTATE
704 MAIN STREET
LAKE GENEVA, WISCONSIN
53147

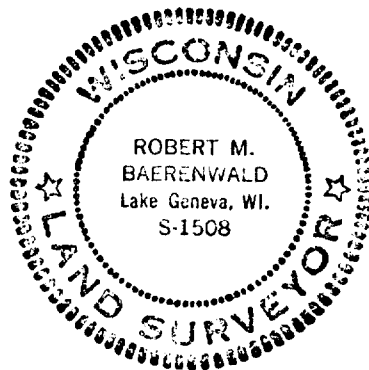

I, ROBERT M. BAERENWALD, HEREBY CERTIFY THAT I
HAVE SURVEYED THE PROPERTY HEREON DESCRIBED ACCORDING
TO THE OFFICIAL RECORDS AND THAT THE PLAT HEREON IS A
CORRECT REPRESENTATION OF THE PROPERTY LINES TO THE
BEST OF MY KNOWLEDGE AND BELIEF.

Robert M. Baerenwald
ROBERT M. BAERENWALD
WISCONSIN REGISTERED LAND SURVEYOR, S-1508

DATE *May 6, 1985*
JOB NO. 0264



SCALE: 1"=20'

+ -CUT CROSS IN CONCRETE

ZOP-00321-ZOP-00322

7-792-B