




SCALE: 1"=20'

- ⊗ - IRON PIPE FOUND
- ⊘ - IRON ROD FOUND
- - IRON ROD FOUND,
IRON PIPE PLACED
- () - RECORDED AS

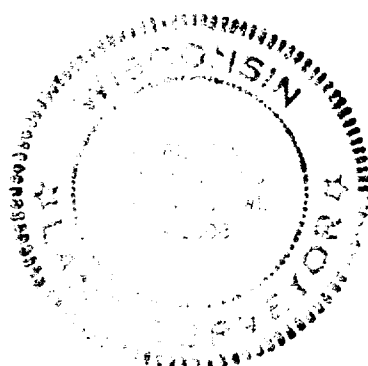

PLAT OF SURVEY OF

UNIT 36 OF SOMMERSET CONDOMINIUM, BEING
PART OF GREENRIDGE DOWNS IN THE CITY OF
LAKE GENEVA, WALWORTH COUNTY, WISCONSIN.


ORDERED BY: SONTAG REALTY
RT. 1, P. O. BOX 360
LAKE GENEVA, WI 53147

I, ROBERT M. BAERENWALD, DO HEREBY CERTIFY THAT I
HAVE SURVEYED THE PROPERTY HEREON DESCRIBED ACCORDING
TO THE OFFICIAL RECORDS AND THAT THE PLAT HEREON IS A
CORRECT REPRESENTATION OF THE PROPERTY LINES TO THE
BEST OF MY KNOWLEDGE AND BELIEF.


Robert M. Baerenwald
ROBERT M. BAERENWALD
WISCONSIN REGISTERED LAND SURVEYOR, S-1508

June 26, 1984
DATE

JOB NO. 0076

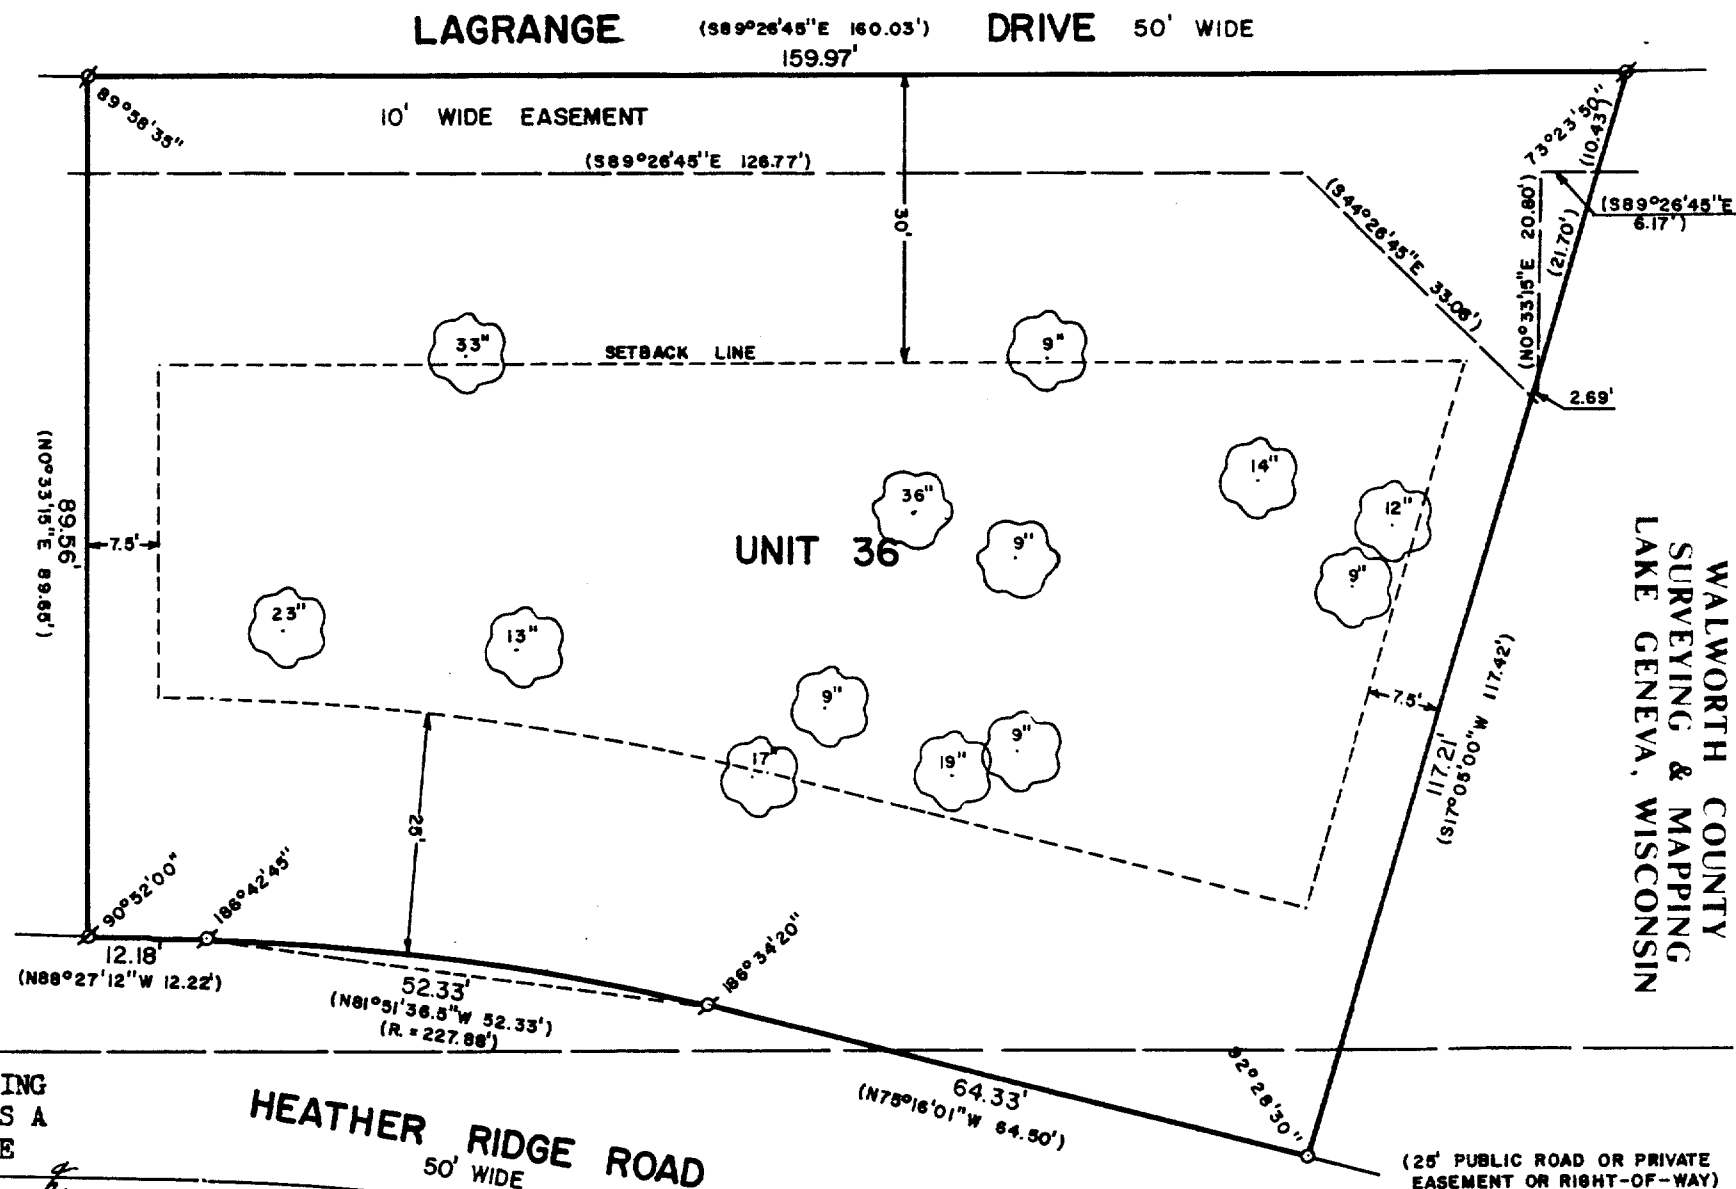

WALWORTH COUNTY
SURVEYING & MAPPING
LAKE GENEVA, WISCONSIN

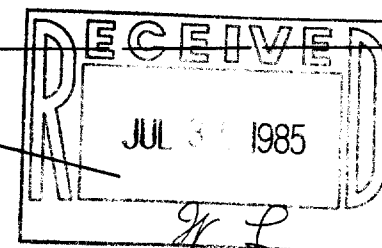

7-799V