


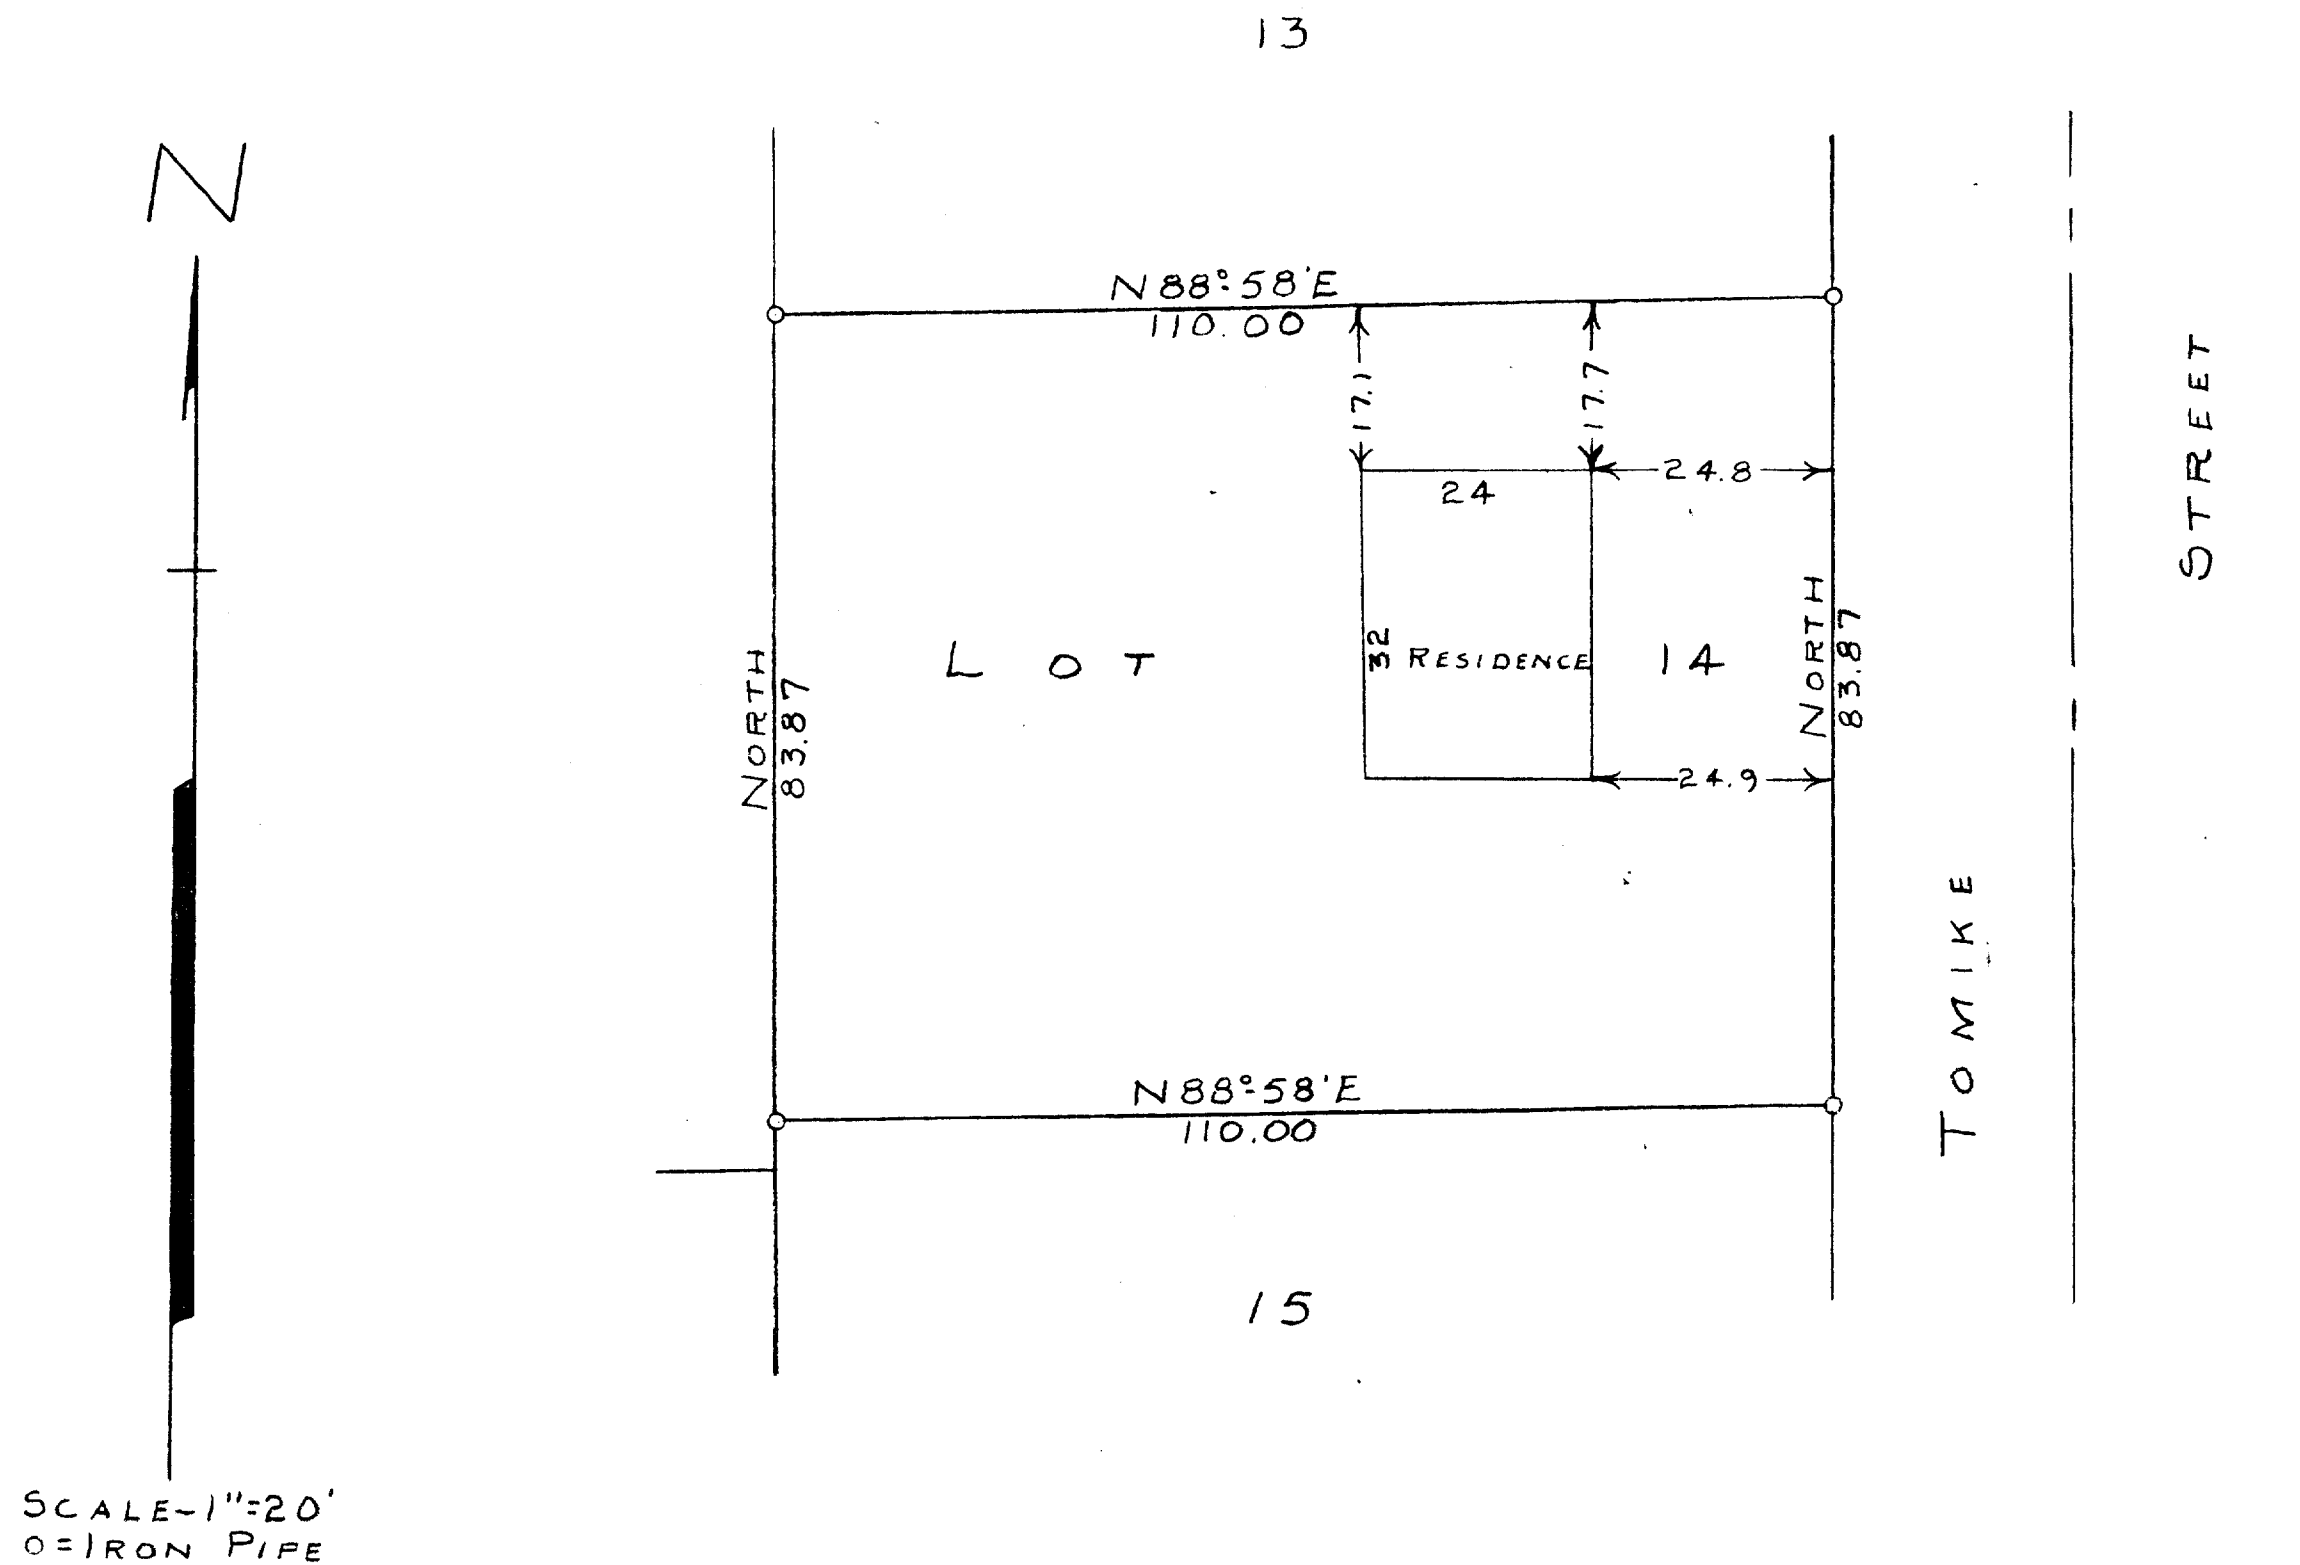

STATE OF WISCONSIN) ss .
COUNTY OF WALWORTH)
I, GEORGE T. DUNHAM, DO HEREBY CERTIFY THAT I HAVE
SURVEYED THE PROPERTY DESCRIBED AS FOLLOWS:
LOT 14 OF MCKENNA ADDITION LOCATED IN THE CITY
OF LAKE GENEVA, WALWORTH COUNTY, WISCONSIN
AND THAT THE PLAT SHOWN ABOVE IS A CORRECT REPRESENTATION
OF THE PROPERTY LINES
JAN 10, 1956

George T. Dunham
GEORGE T. DUNHAM, SURVEYOR
DE AVAN, WISCONSIN