
WALWORTH COUNTY SURVEYING & MAPPING LAKE GENEVA, WISCONSIN

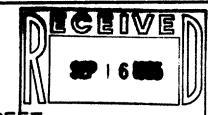


SPRING STREE (120') 119.43' (60') 60.80' 12 IRON PIPE 0.30' SOUTH OF LOT FOUND IRON ROD 13.6 32.4 DRIVE 5 WAY RESIDENCE 2.5 STREET 2.5 3 5 8 10 C 4 兮 OVERHEAD UTILITIES ALONG LOT LINE **WIDE** (60.9) (120')

PLAT OF SURVEY OF

ALLEY

ORDERED BY: JOHN LAW REALTORS LAKE GENEVA, WISCONSIN LOT 4. BLOCK 15 OF GENEVA LAKE CRAWFORD MANUFACTURING CO. ADDITION TO THE CITY OF LAKE GENEVA, WALWORTH COUNTY, WISCONSIN.

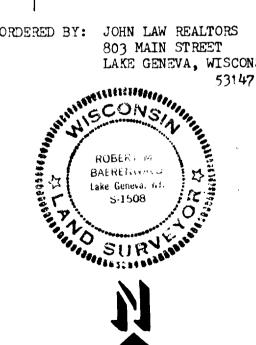

I HEREBY CERTIFY THAT I HAVE SURVEYED THE ABOVE DESCRIBED PROPERTY AND THAT THE ABOVE MAP IS A TRUE REPRESENTATION THEREOF AND SHOWS THE SIZE AND LOCATION OF THE PROPERTY, ITS EXTERIOR BOUNDARIES, THE LOCATION OF ALL VISIBLE STRUCTURES AND DIMENSIONS OF ALL PRINCIPAL BUILDINGS THEREON, BOUNDARY FENCES, APPARENT EASEMENTS, ROADWAYS AND VISIBLE ENCROACHMENTS, IF ANY.

THIS SURVEY IS MADE FOR THE USE OF THE PRESENT OWNERS OF THE PROPERTY AND ALSO THOSE WHO PURCHASE, MORTGAGE, OR GUARANTEE THE TITLE THERETO WITHIN ONE (1) YEAR FROM DATE HEREOF.

ROBERT M. BAERENWALD WISCONSIN REGISTERED LAND SURVEYOR, S-1508

SCALE: 1"=30"

ø −IRON PIPE FOUND o - IRON ROD PLACED ()-RECORDED AS

16'