


PLAT OF SURVEY OF PART OF LOT 1 OF CERTIFIED SURVEY MAP NO. 643 LOCATED IN THE SOUTHWEST 1/4

OF SECTION 1, T1N, R17E

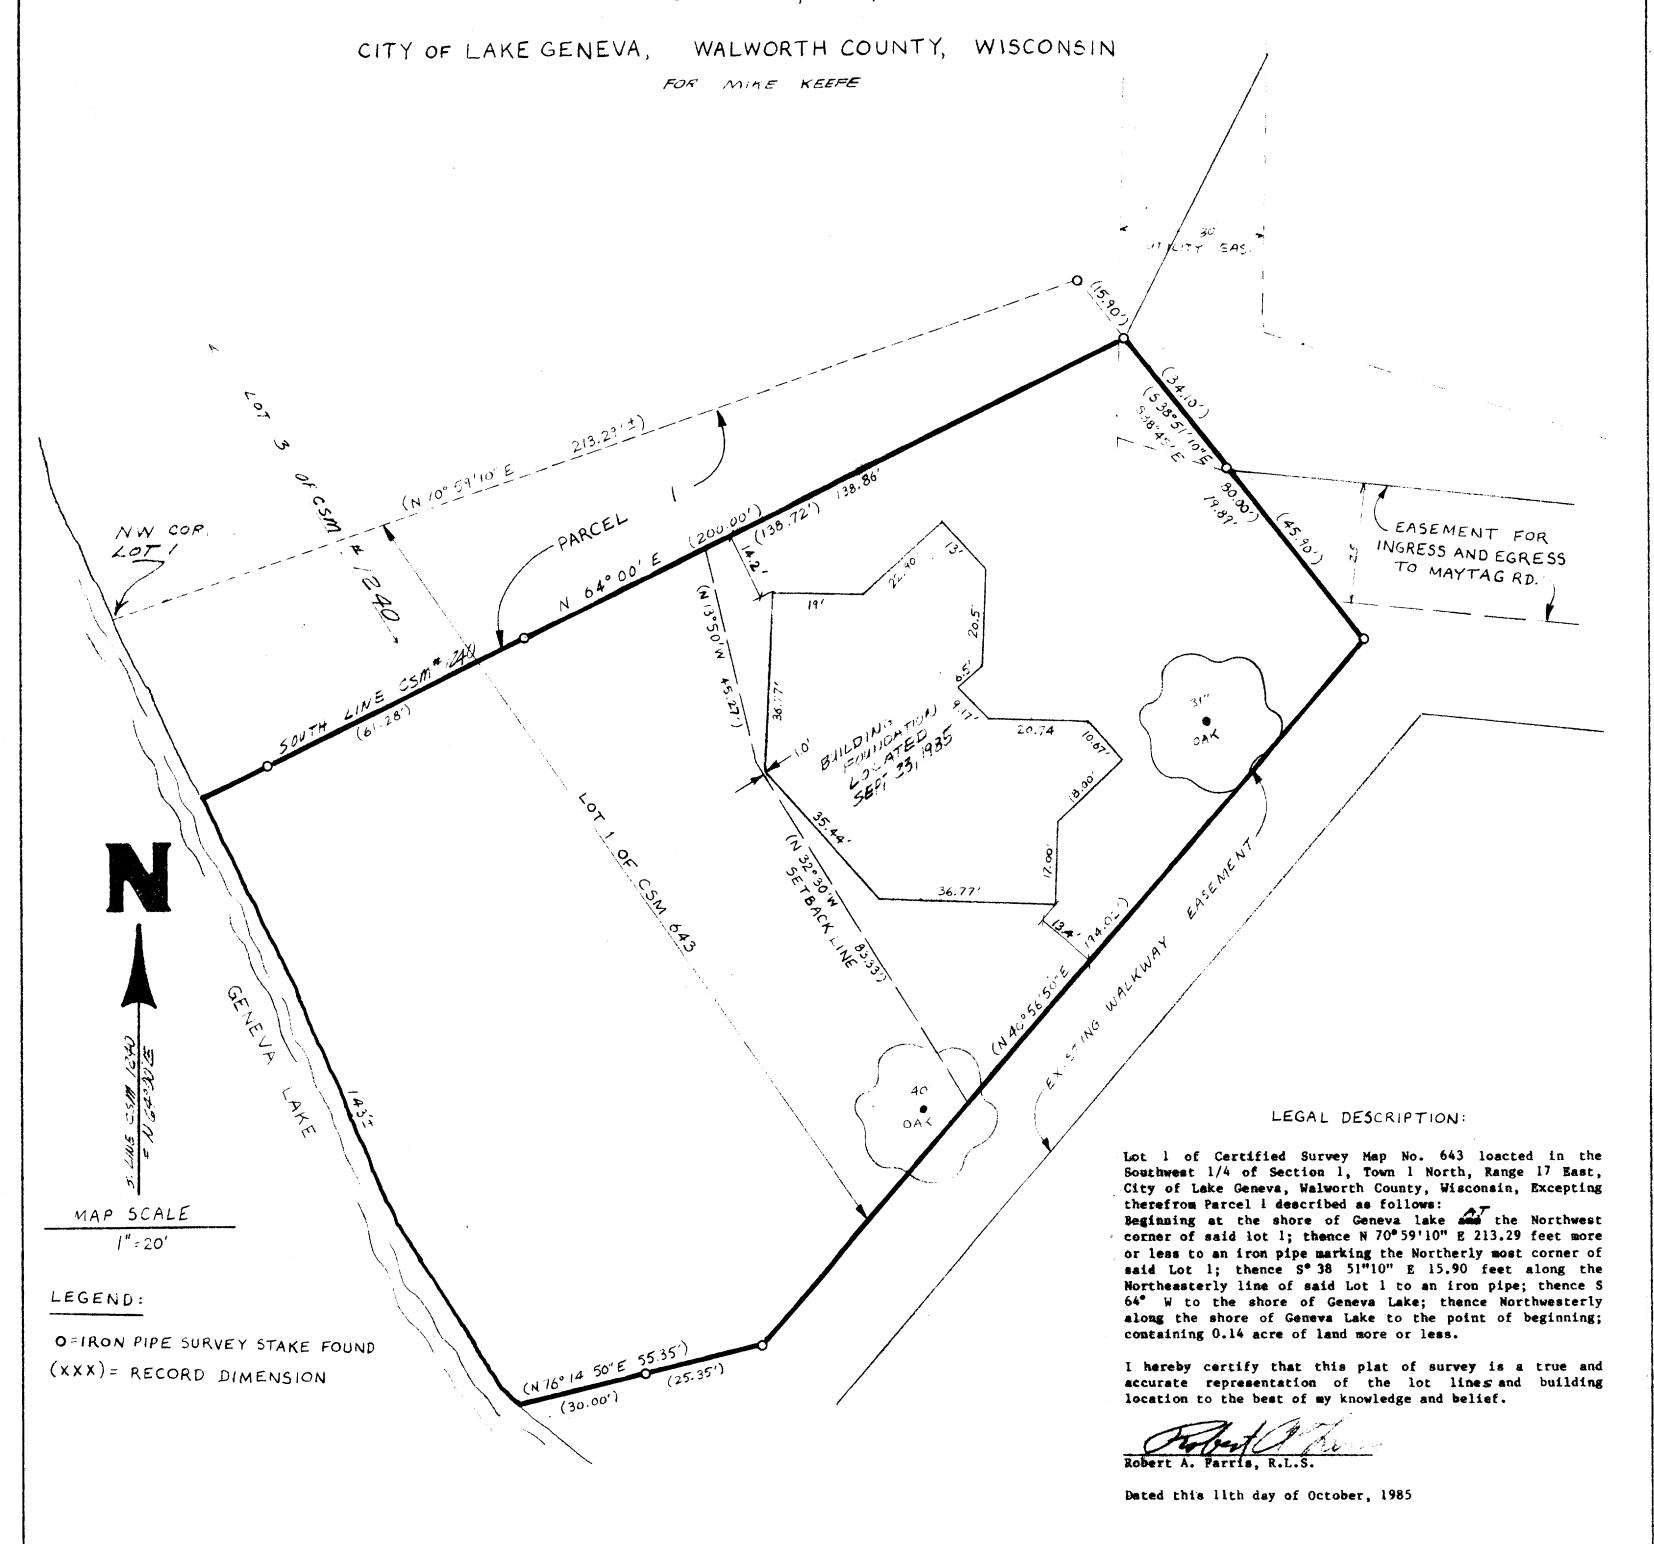

FARRIS, HANSEN & ASSOCIATES, INC.

ENGINEERING, SURVEYING & LAND PLANNING
7 RIGGEWAY CT. -BOX 487-ELKHORN, WI.
PHONE: 414-723-2908