




WALWORTH COUNTY
SURVEYING & MAPPING
LAKE GENEVA, WISCONSIN

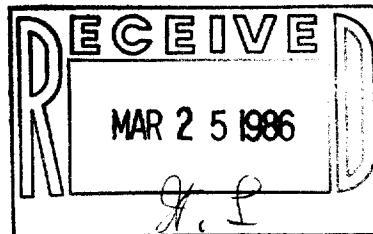

PLAT OF SURVEY OF

THE WEST 95 FEET OF LOT 18, BLOCK 1 OF THE
ORIGINAL PLAT OF THE VILLAGE, NOW CITY, OF
LAKE GENEVA, WALWORTH COUNTY, WISCONSIN.

ORDERED BY: CENTURY 21
152 CENTER STREET, SUITE 200
LAKE GENEVA, WISCONSIN 53147

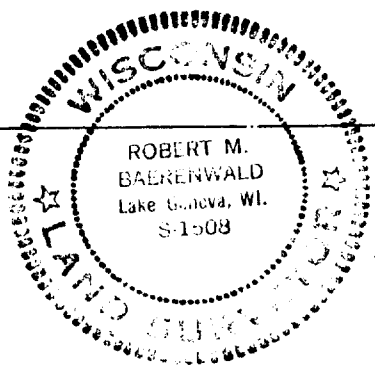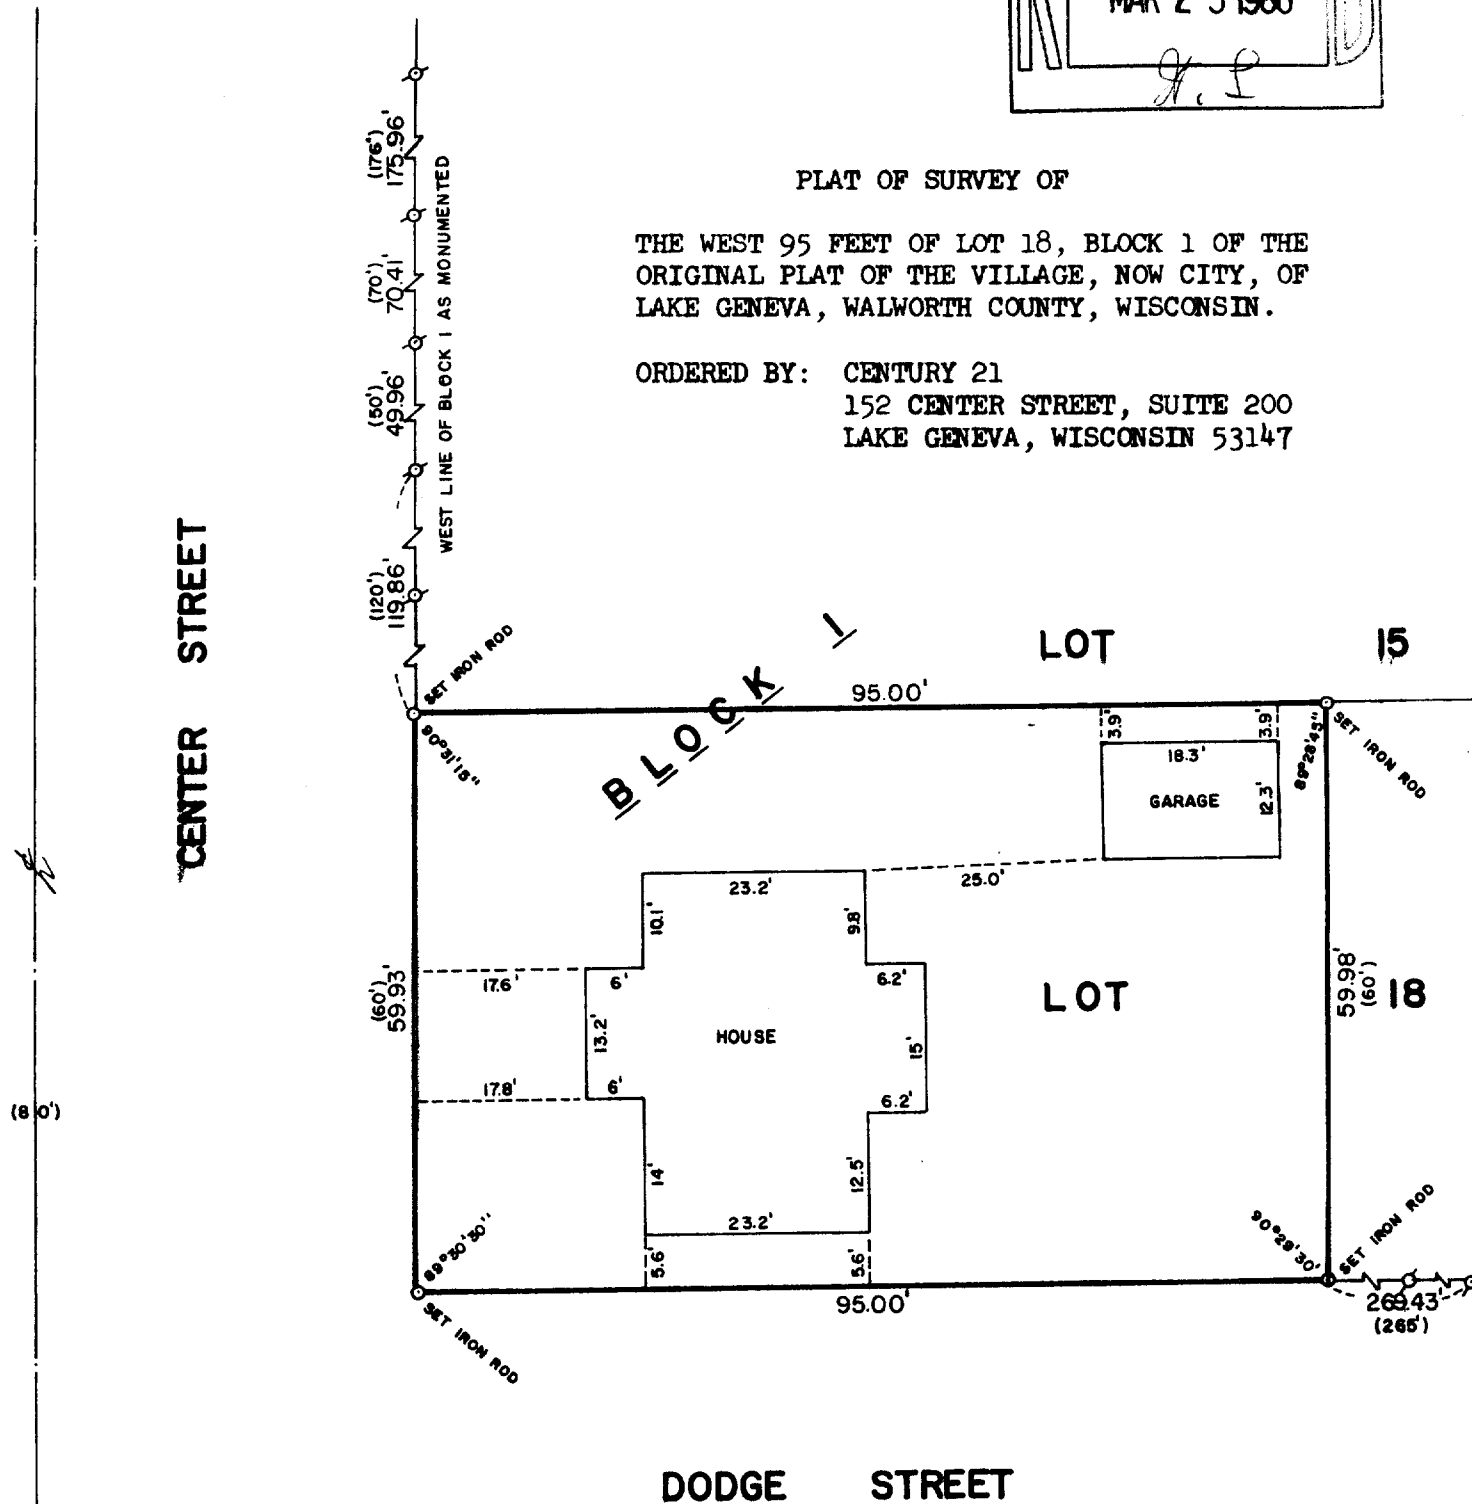

SCALE: 1"=20'

⊕ - IRON PIPE FOUND
○ - IRON ROD SET
() - RECORDED AS

I, ROBERT M. BAERENWALD, DO HEREBY CERTIFY THAT I
HAVE SURVEYED THE PROPERTY HEREON DESCRIBED ACCORDING
TO THE OFFICIAL RECORDS AND THAT THE PLAT HEREON IS A
CORRECT REPRESENTATION OF THE PROPERTY LINES TO THE
BEST OF MY KNOWLEDGE AND BELIEF.

Robert M. Baerenwald
ROBERT M. BAERENWALD
WISCONSIN REGISTERED LAND SURVEYOR, S-1508

Dec. 13, 1985
DATE JOB NO. 0436

20P 82

7-822