


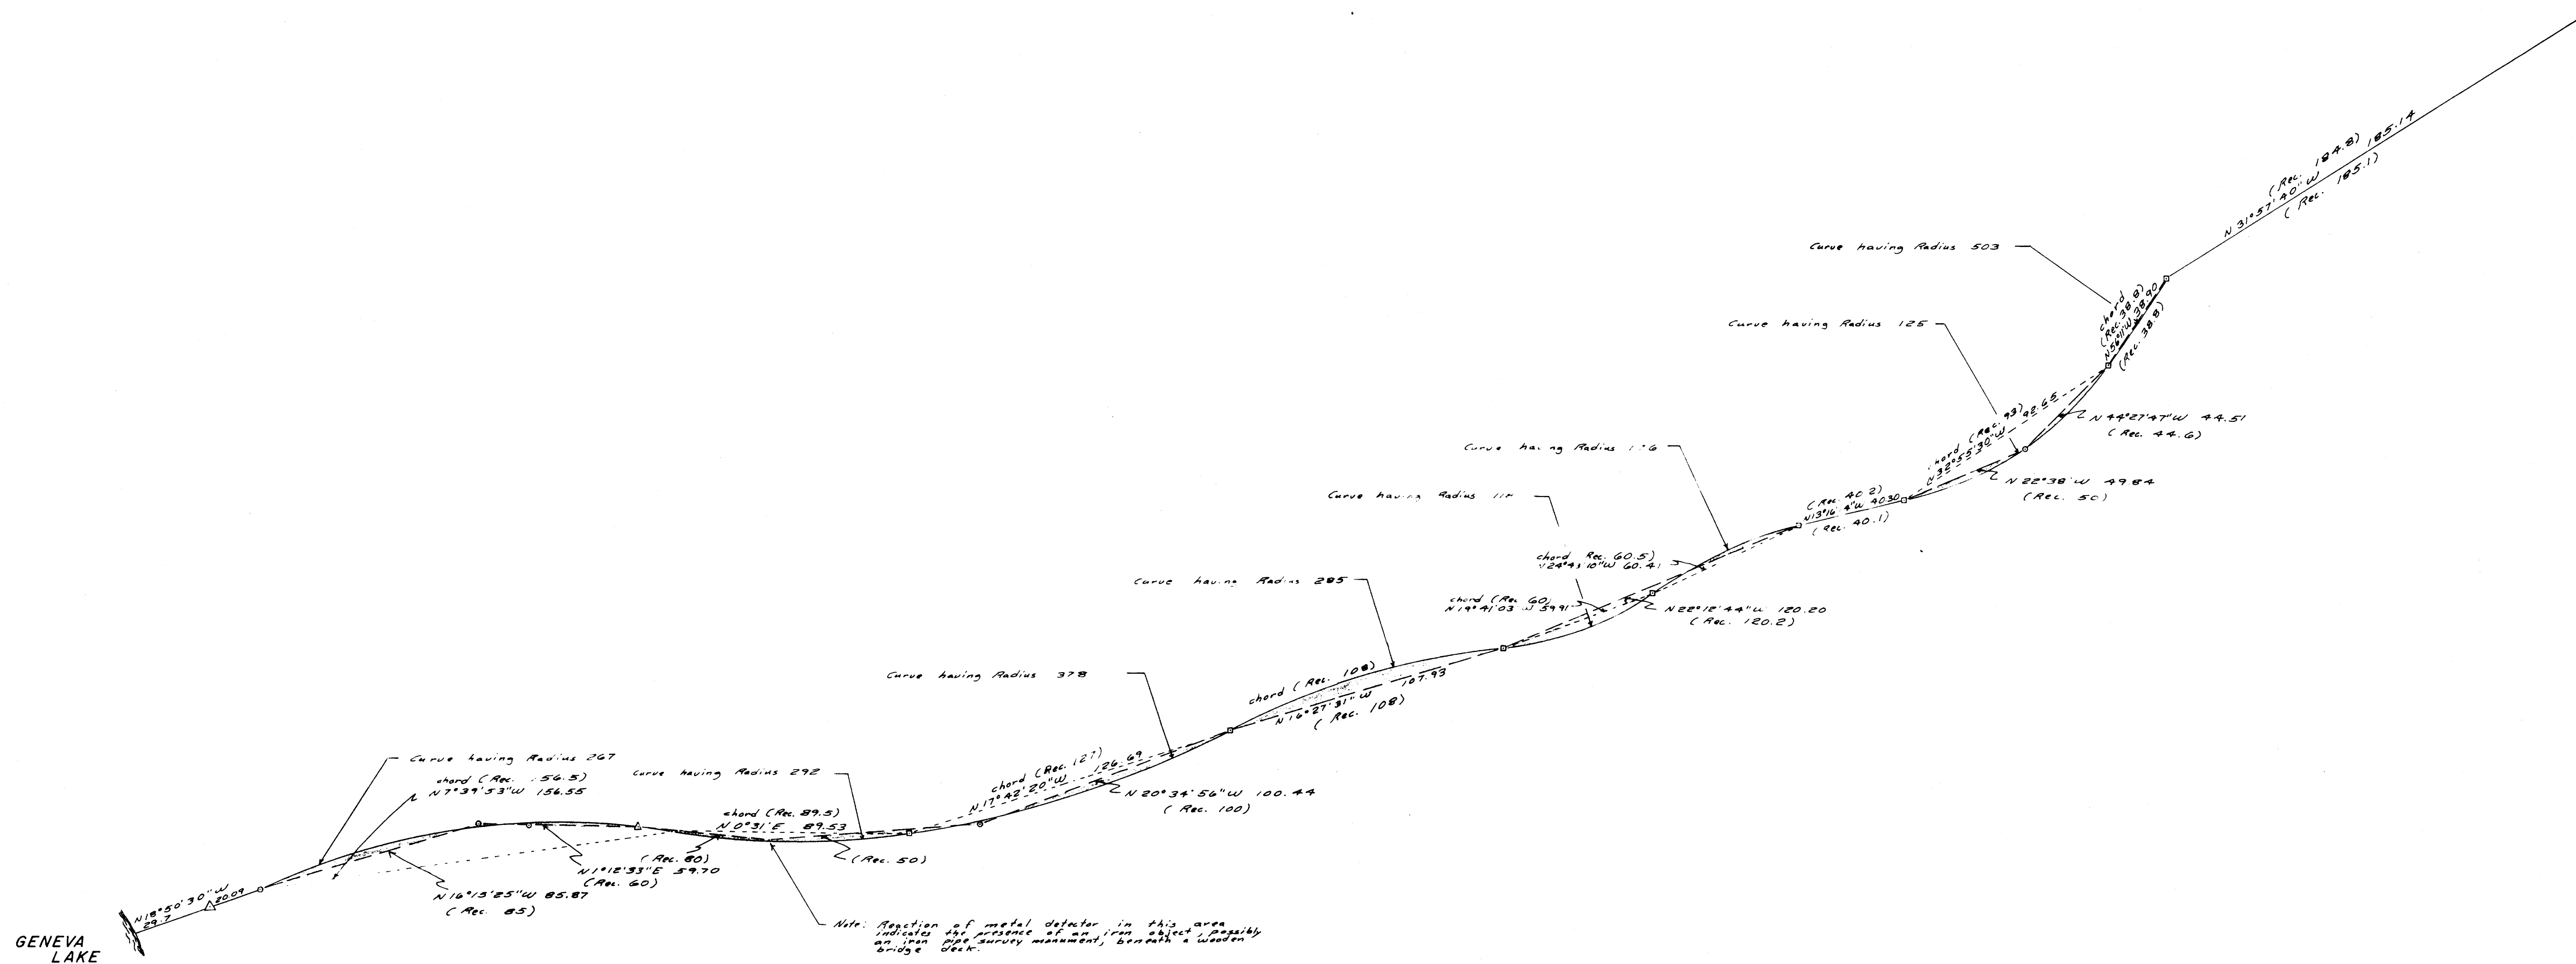

LEGEND

- - Found Octagonal Stone Monument With Lead Cr.
- - Found Iron Pipe Survey Monument
- △ - Found X cut in Concrete
- △ - Made X cut in Concrete
- Boundary of land conveyed to Carpenter in 1908
- chords of curves in description used above
- Boundary of land conveyed to Schmidt in 1924
- Shaded Area is land between the above mentioned boundaries

DETAIL OF PART OF THE ABRA C.
PRENTICE ESTATE LOCATED IN
SEC. 35, T.2N., R.17E.

DRAWN BY R.A.F.	JENSEN & JOHNSON CIVIL ENGINEERS ELKHORN, WIS.	SCALE: 1" = 30'
CHECKED BY <i>[Signature]</i>		REVISED
APPROVED BY		SHEET NO. 2 OF 2
DATE Sept. 1972		7-82