


ABERNATHY and ASSOCIATES

Kenneth B. Abernathy Jr.

Wisconsin Registered Land Surveyor S-1594


Rt. 3, Box 273
Elkhorn, Wisconsin 53121
Phone: (414) 723-4260 (office)
(414) 723-4813 (residence)

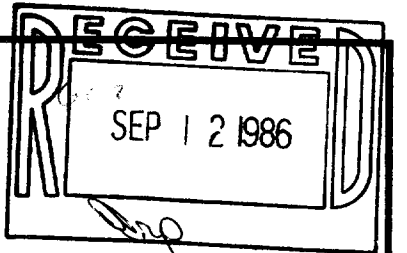

PLAT OF SURVEY
UNIT "A", OF BUILDING 3, OF LAKE GENEVA WOODLANDS
CONDOMINIUM.

A CONDOMINIUM LOCATED IN LOT 9, AND PART OF LOTS 7, 8, 10, OF BLOCK 2 OF LAKE GENEVA HILLS SUBDIVISION, A SUBDIVISION LOCATED IN THE SE. 1/4 OF SECTION 26, T2N, R17E, CITY OF LAKE GENEVA, WALWORTH COUNTY, WISCONSIN.

EXPANSION AREA

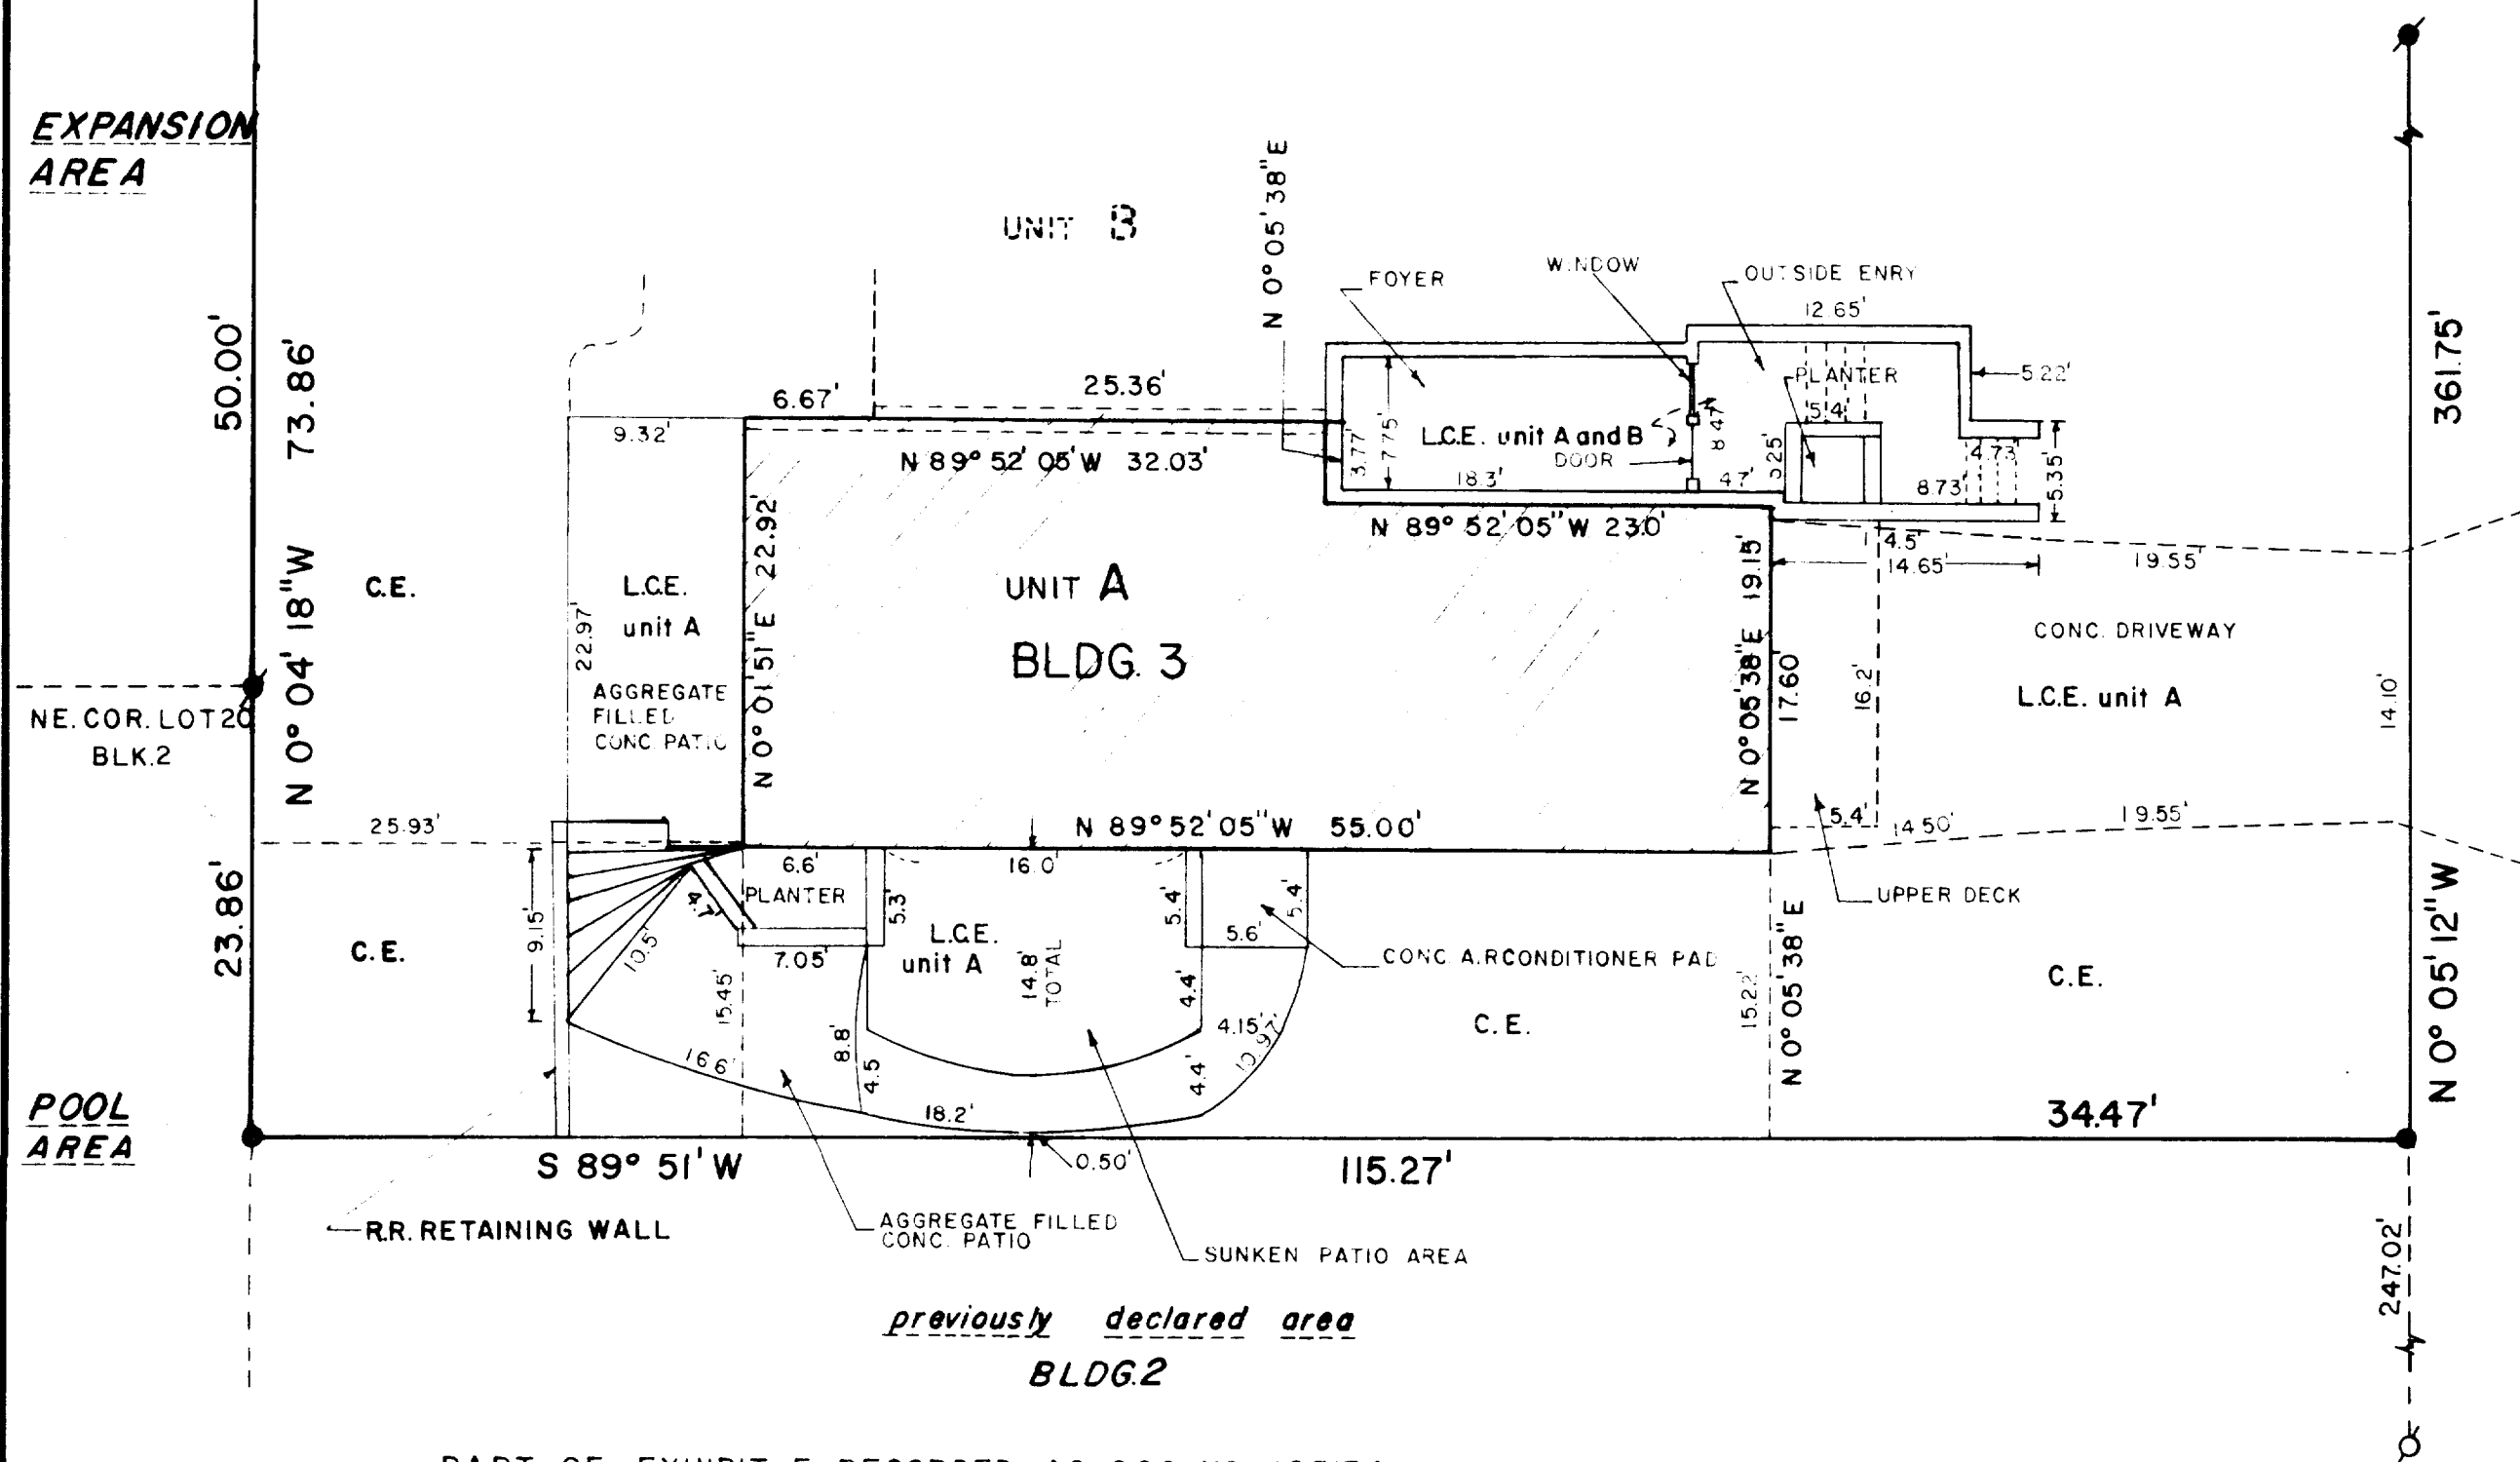

KENDALL LANE
(FORMERLY BEST AVE.)
50' WIDE PUBLIC ROAD

PLATTED LAND
OWNED BY OTHERS
BLOCK 1

Legend

- FOUND IRON PIPE
- FOUND IRON ROD
- FOUND BRASS CAPPED MONUMENT
- FOUND CONCRETE MONUMENT
- CHISEL CUT IN CONCRETE
- SET IRON ROD, 24" LONG, WEIGHING 1.5 LBS./LINEAL FT., 3/4" DIA.
- SET IRON ROD, 30" LONG, WEIGHING 4.5 LBS./LINEAL FT., 1-11/16" DIA.
- (xx) RECORDED AS DIMENSION
- EXISTING FENCE



SCALE: 1" = 10 FEET

"I hereby certify that I have surveyed the above described property and that the above map is a true representation thereof and shows the size and location of the property, its exterior boundaries, the location of all visible structures and dimensions of all principal buildings thereon, boundary fences, apparent easements, roadways and visible encroachments, if any."
"This survey is made for the use of the present owners of the property, and also those who purchase, mortgage, or guarantee the title thereto within one year from date hereof."

C.E. - COMMON ELEMENT.
L.C.E. - LIMITED COMMON ELEMENT.

PART OF EXHIBIT F RECORDED AS DOC. NO. 105134 OF CONDOMINIUMS REGISTER OF DEEDS OFFICE, WALWORTH COUNTY, WISCONSIN.

SE. CORNER LOT 13, BLK. 2

KENNETH B. ABERNATHY, JR.
WISCONSIN REGISTERED LAND SURVEYOR,
S-1594
Date: 6/2/86 Job No. 501-83