


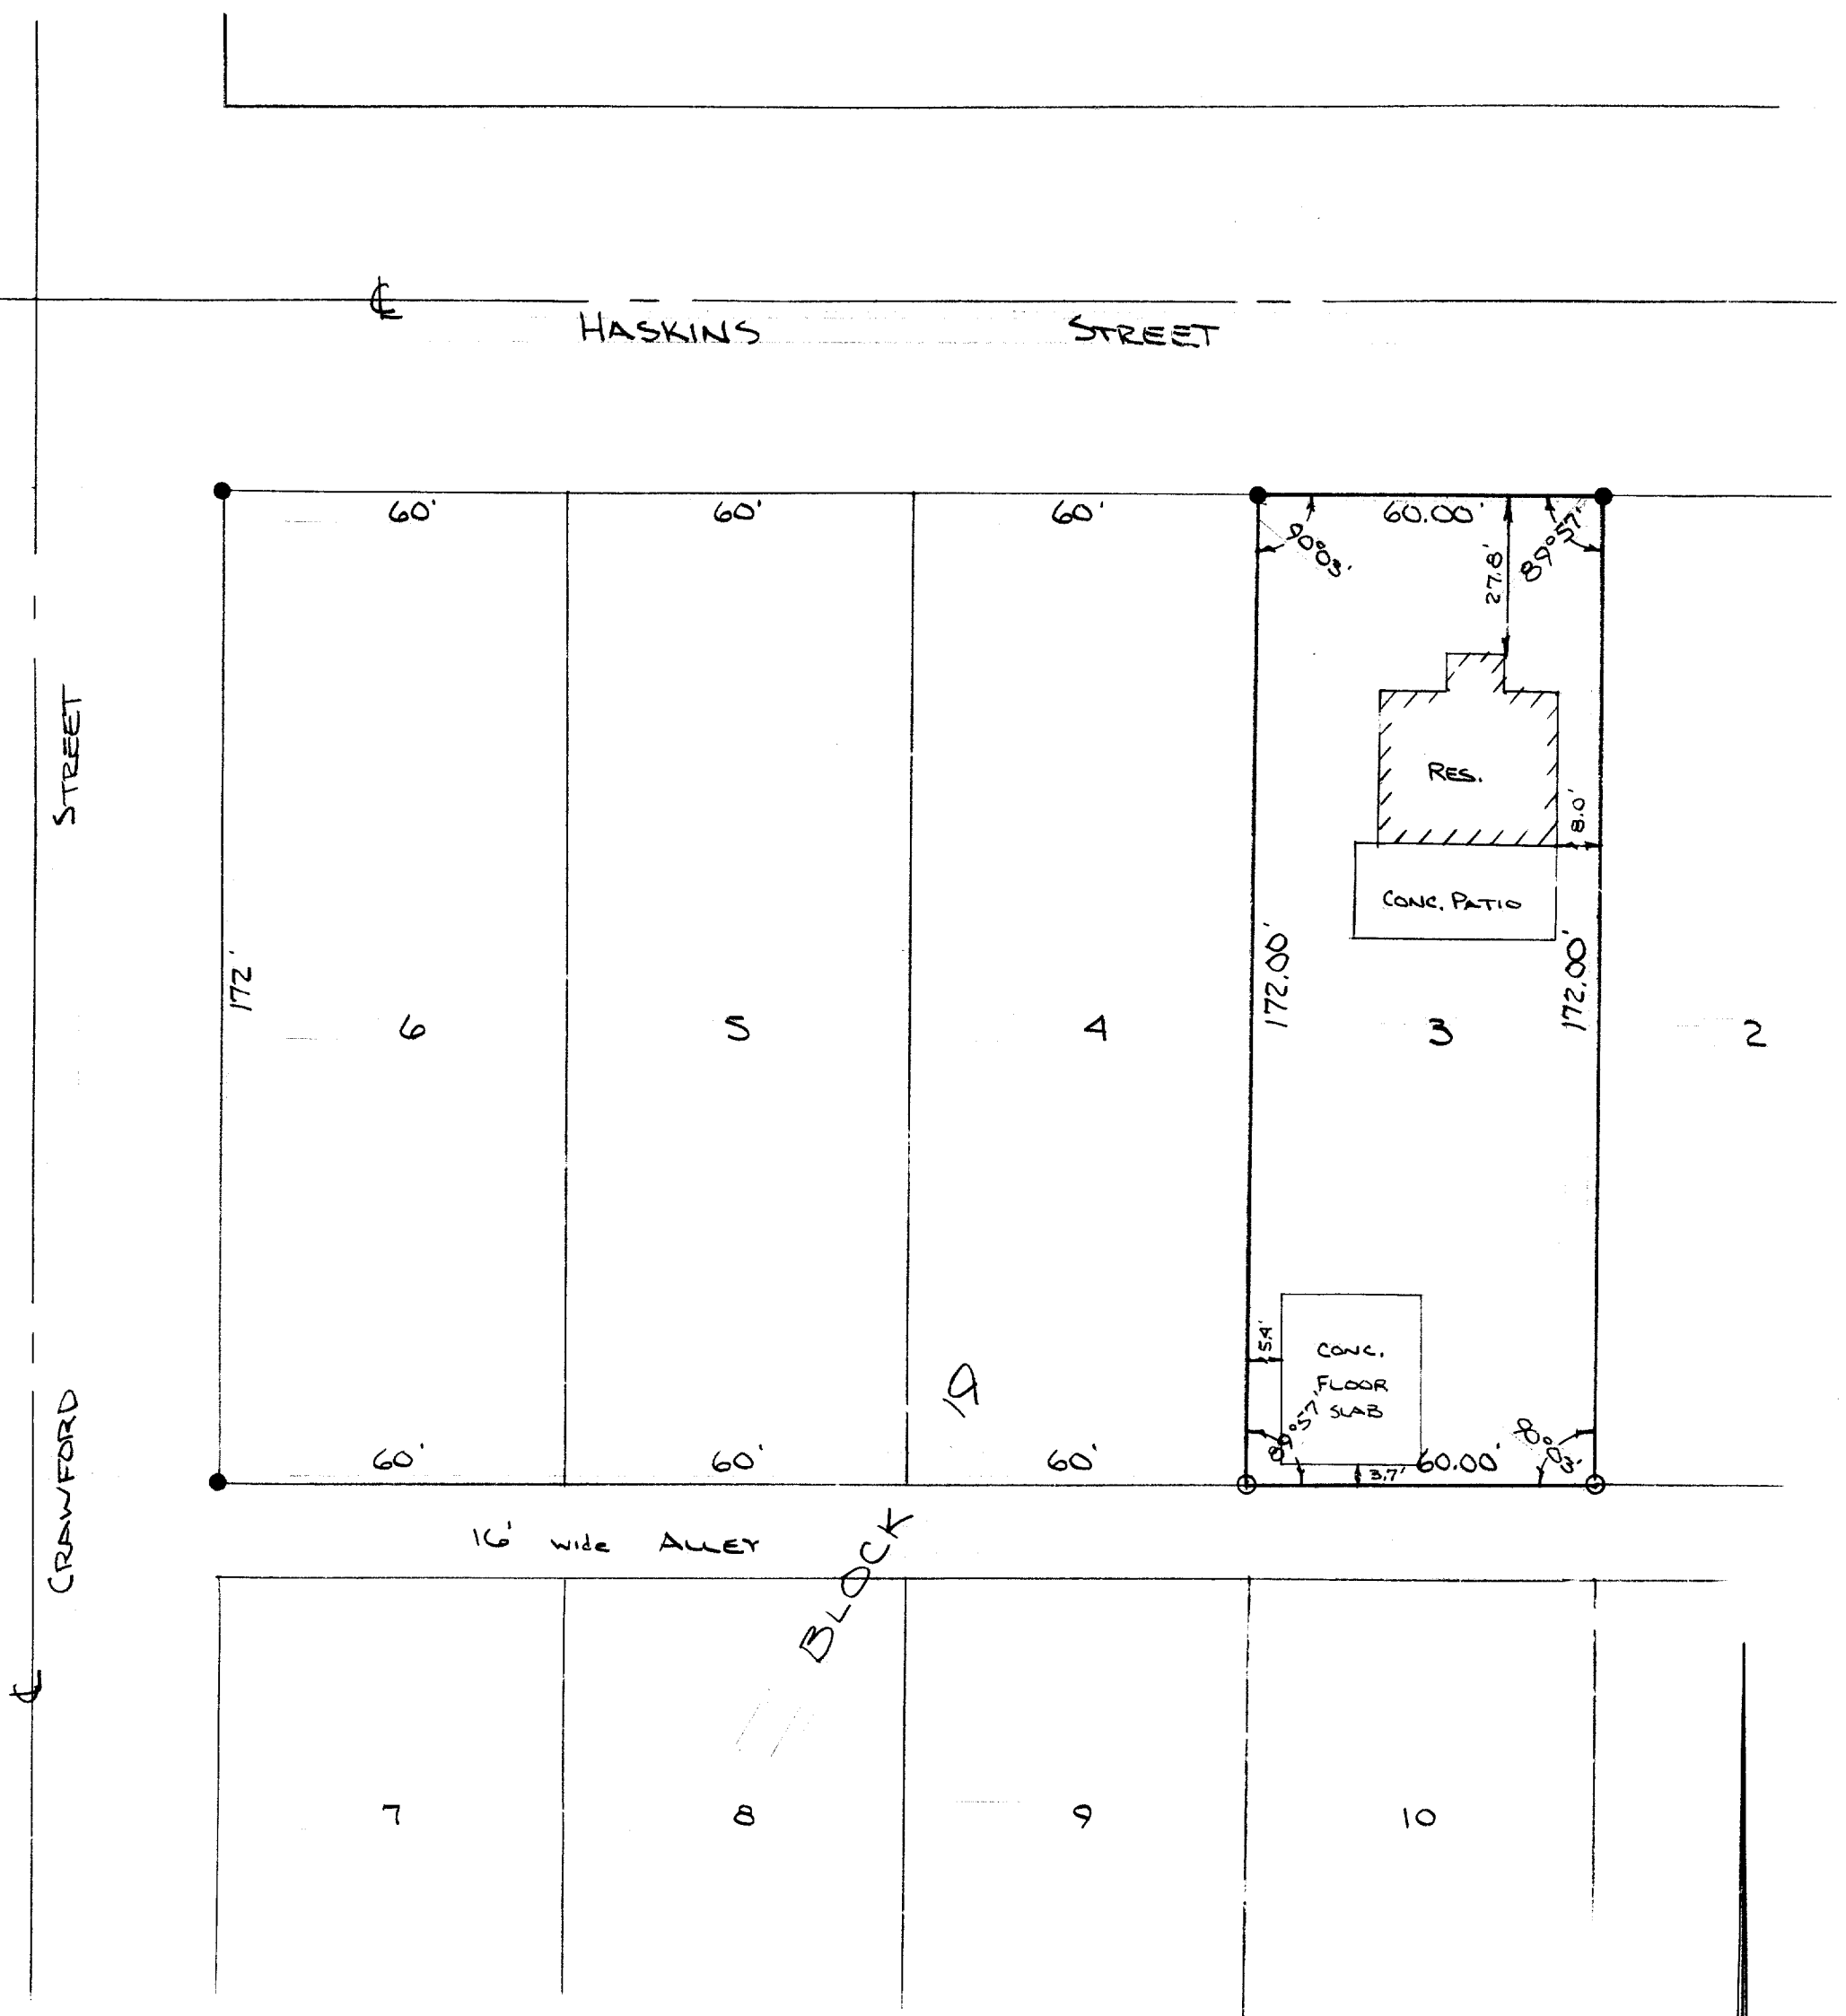

DESCRIPTION:

All of Lot 3 Block 19 of Geneva Lake Crawford Mfg. Co. Addition, a subdivision located in the SE $\frac{1}{4}$ of Section 25, T2N, R17E, Lake Geneva, Walworth County, Wisconsin

CERTIFICATE:

I, Joseph M. Biagi, surveyor, do hereby certify that I have surveyed the Property hereon described.

DATE:

November 26, 1973

● - INDICATES IRON PIPE FOUND
○ - INDICATES IRON PIPE SET

Joseph M. Biagi
Elkhorn, Wisconsin

RLS #12

LOT 3 BLOCK 19 GENEVA LAKE CRAWFORD MFG. CO. ADD.		
SCALE: 1"=30'-0"	APPROVED BY:	DRAWN BY GW
DATE: Nov. 26, '73		REVISED
ENGINEERS ASSOCIATED, INC. 808 W. WALWORTH STREET ELKHORN, WISCONSIN 53121		
		DRAWING NUMBER 127-73