
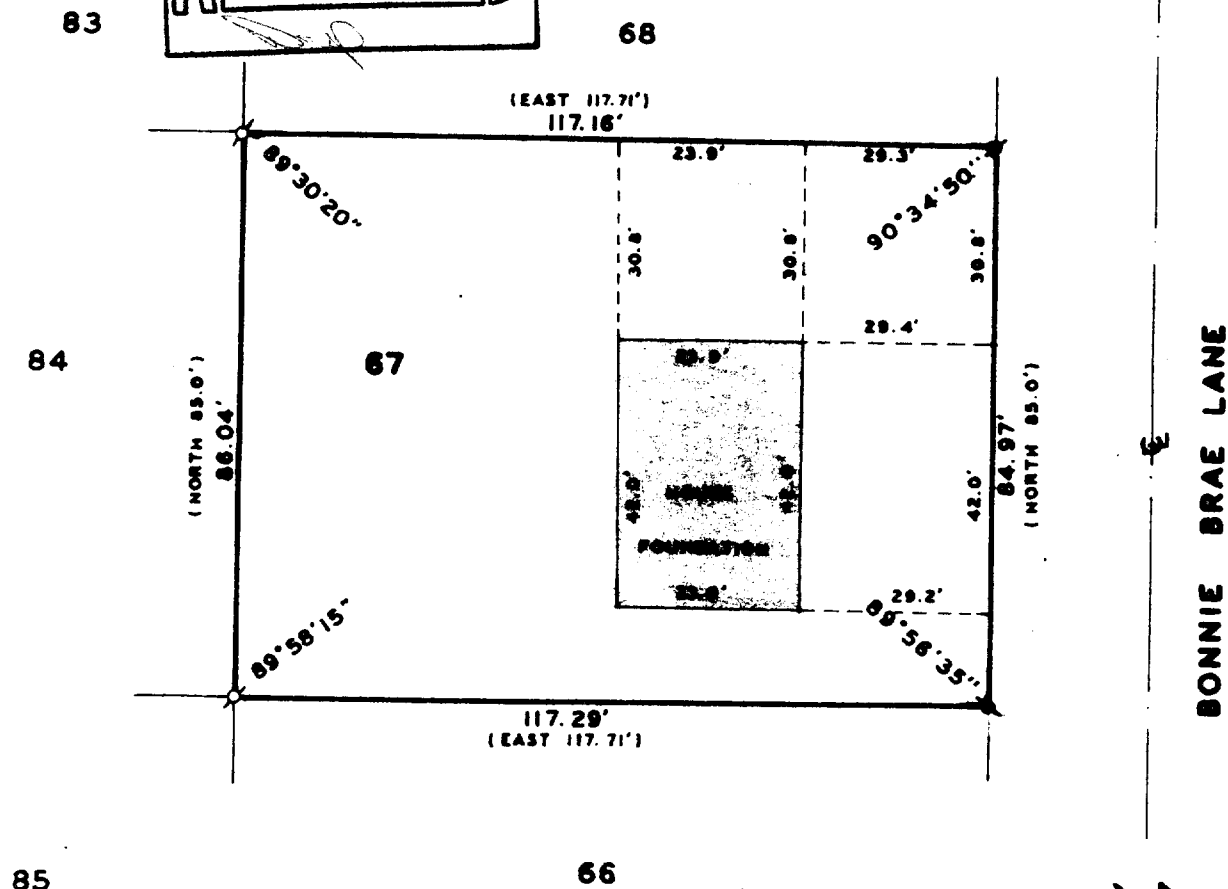


LAND SURVEYING • SUBDIVIDING • LAND PLANNING

LAKE GENEVA, WISCONSIN 53147

414-248-3697

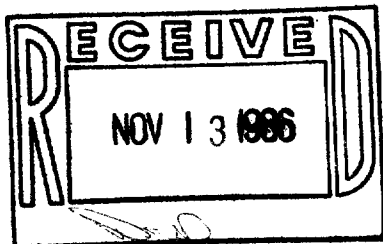

SCALE: 1" = 30'

LEGEND

Ø - IRON PIPE FOUND
 ● - IRON ROD FOUND
 () - AS RECORDED

ORDERED BY:

FIVE STAR HOMES
90 E. GENEVA SQUARE
LAKE GENEVA, WI. 53147

PLAT OF SURVEY

LOT 67 OF H.E. WELLS ADDITION TO THE
CITY OF LAKE GENEVA, WALWORTH COUNTY
WISCONSIN.

I, HAROLD H. KOLB, DO HEREBY CERTIFY THAT I HAVE SURVEYED THE PROPERTY HEREON DESCRIBED ACCORDING TO THE OFFICIAL RECORDS AND THAT THE PLAT HEREON IS A CORRECT REPRESENTATION OF THE LOT LINES AND THE PRINCIPAL LINES OF THE FOUNDATION, TO THE BEST OF MY KNOWLEDGE AND BELIEF.

Harold V. Kold

HAROLD H. KOLB

WISCONSIN REGISTERED LAND SURVEYOR, S-187

DATE JULY 22, 1986

REVISÉD

REVISÉ

