
WALWORTH COUNTY SURVEYING & MAPPING LAKE GENEVA, WISCONSIN



ORDERED BY: MARILYN D'LUGOSZ RT. 3, BOX 400

LAKE GENEVA, WISCONSIN 53147

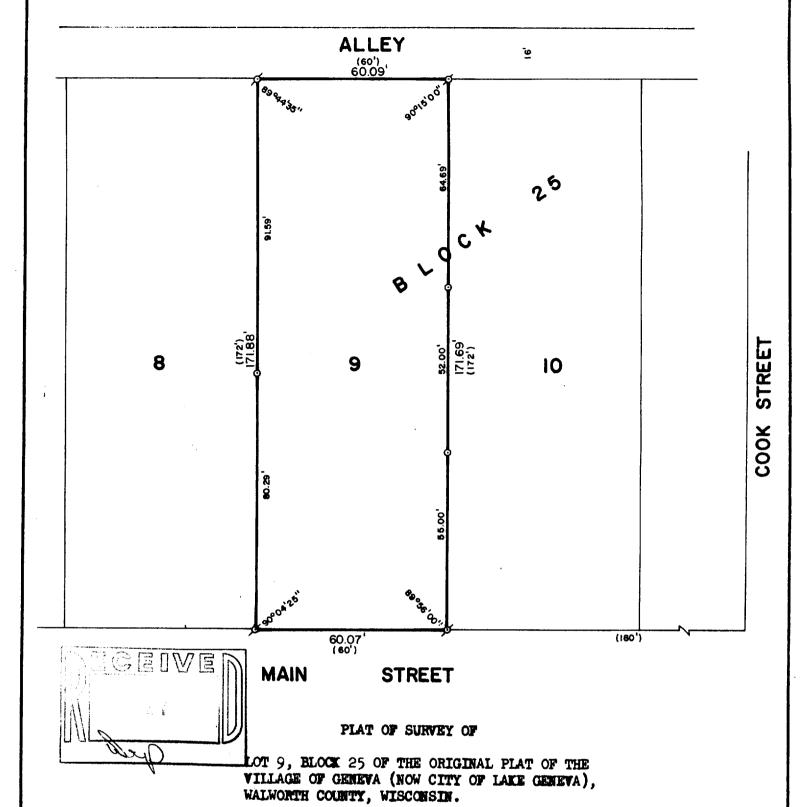

SCALE: 1"=30'

p - IRON PIPE FOUND O - IRON ROD PLACED ()-RECORDED AS

I, ROBERT M. BAERENWALD, DO HEREBY CERTIFY THAT I HAVE SURVEYED THE PROPERTY HEREON DESCRIBED ACCORDING TO THE OFFICIAL RECORDS AND THAT THE PLAT HEREON IS A CORRECT REPRESENTATION OF THE PROPERTY LINES TO THE BEST OF MY KNOWLEDGE AND BELIEF.

ROBERT M. BAERENWALD
WISCONSIN RECTURED

WISCONSIN REGISTERED LAND SURVEYOR, 5-1508

JOB NO. 0672

NOTE: THIS IS NOT A CERTIFIED COPY UNLESS SEALED.

268-240