


**SURVEYING & ENGINEERING
ELAVAN, WISCONSI**

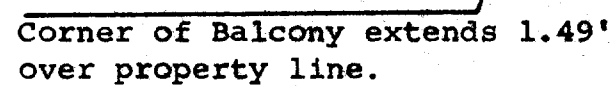

I, George T. Dunham, do hereby certify that I have surveyed the property described as follows:

and that the plat shown above is a correct representation of the property lines and of the improvements located thereon.

George T. Dunham
George T. Dunham, Surveyor