


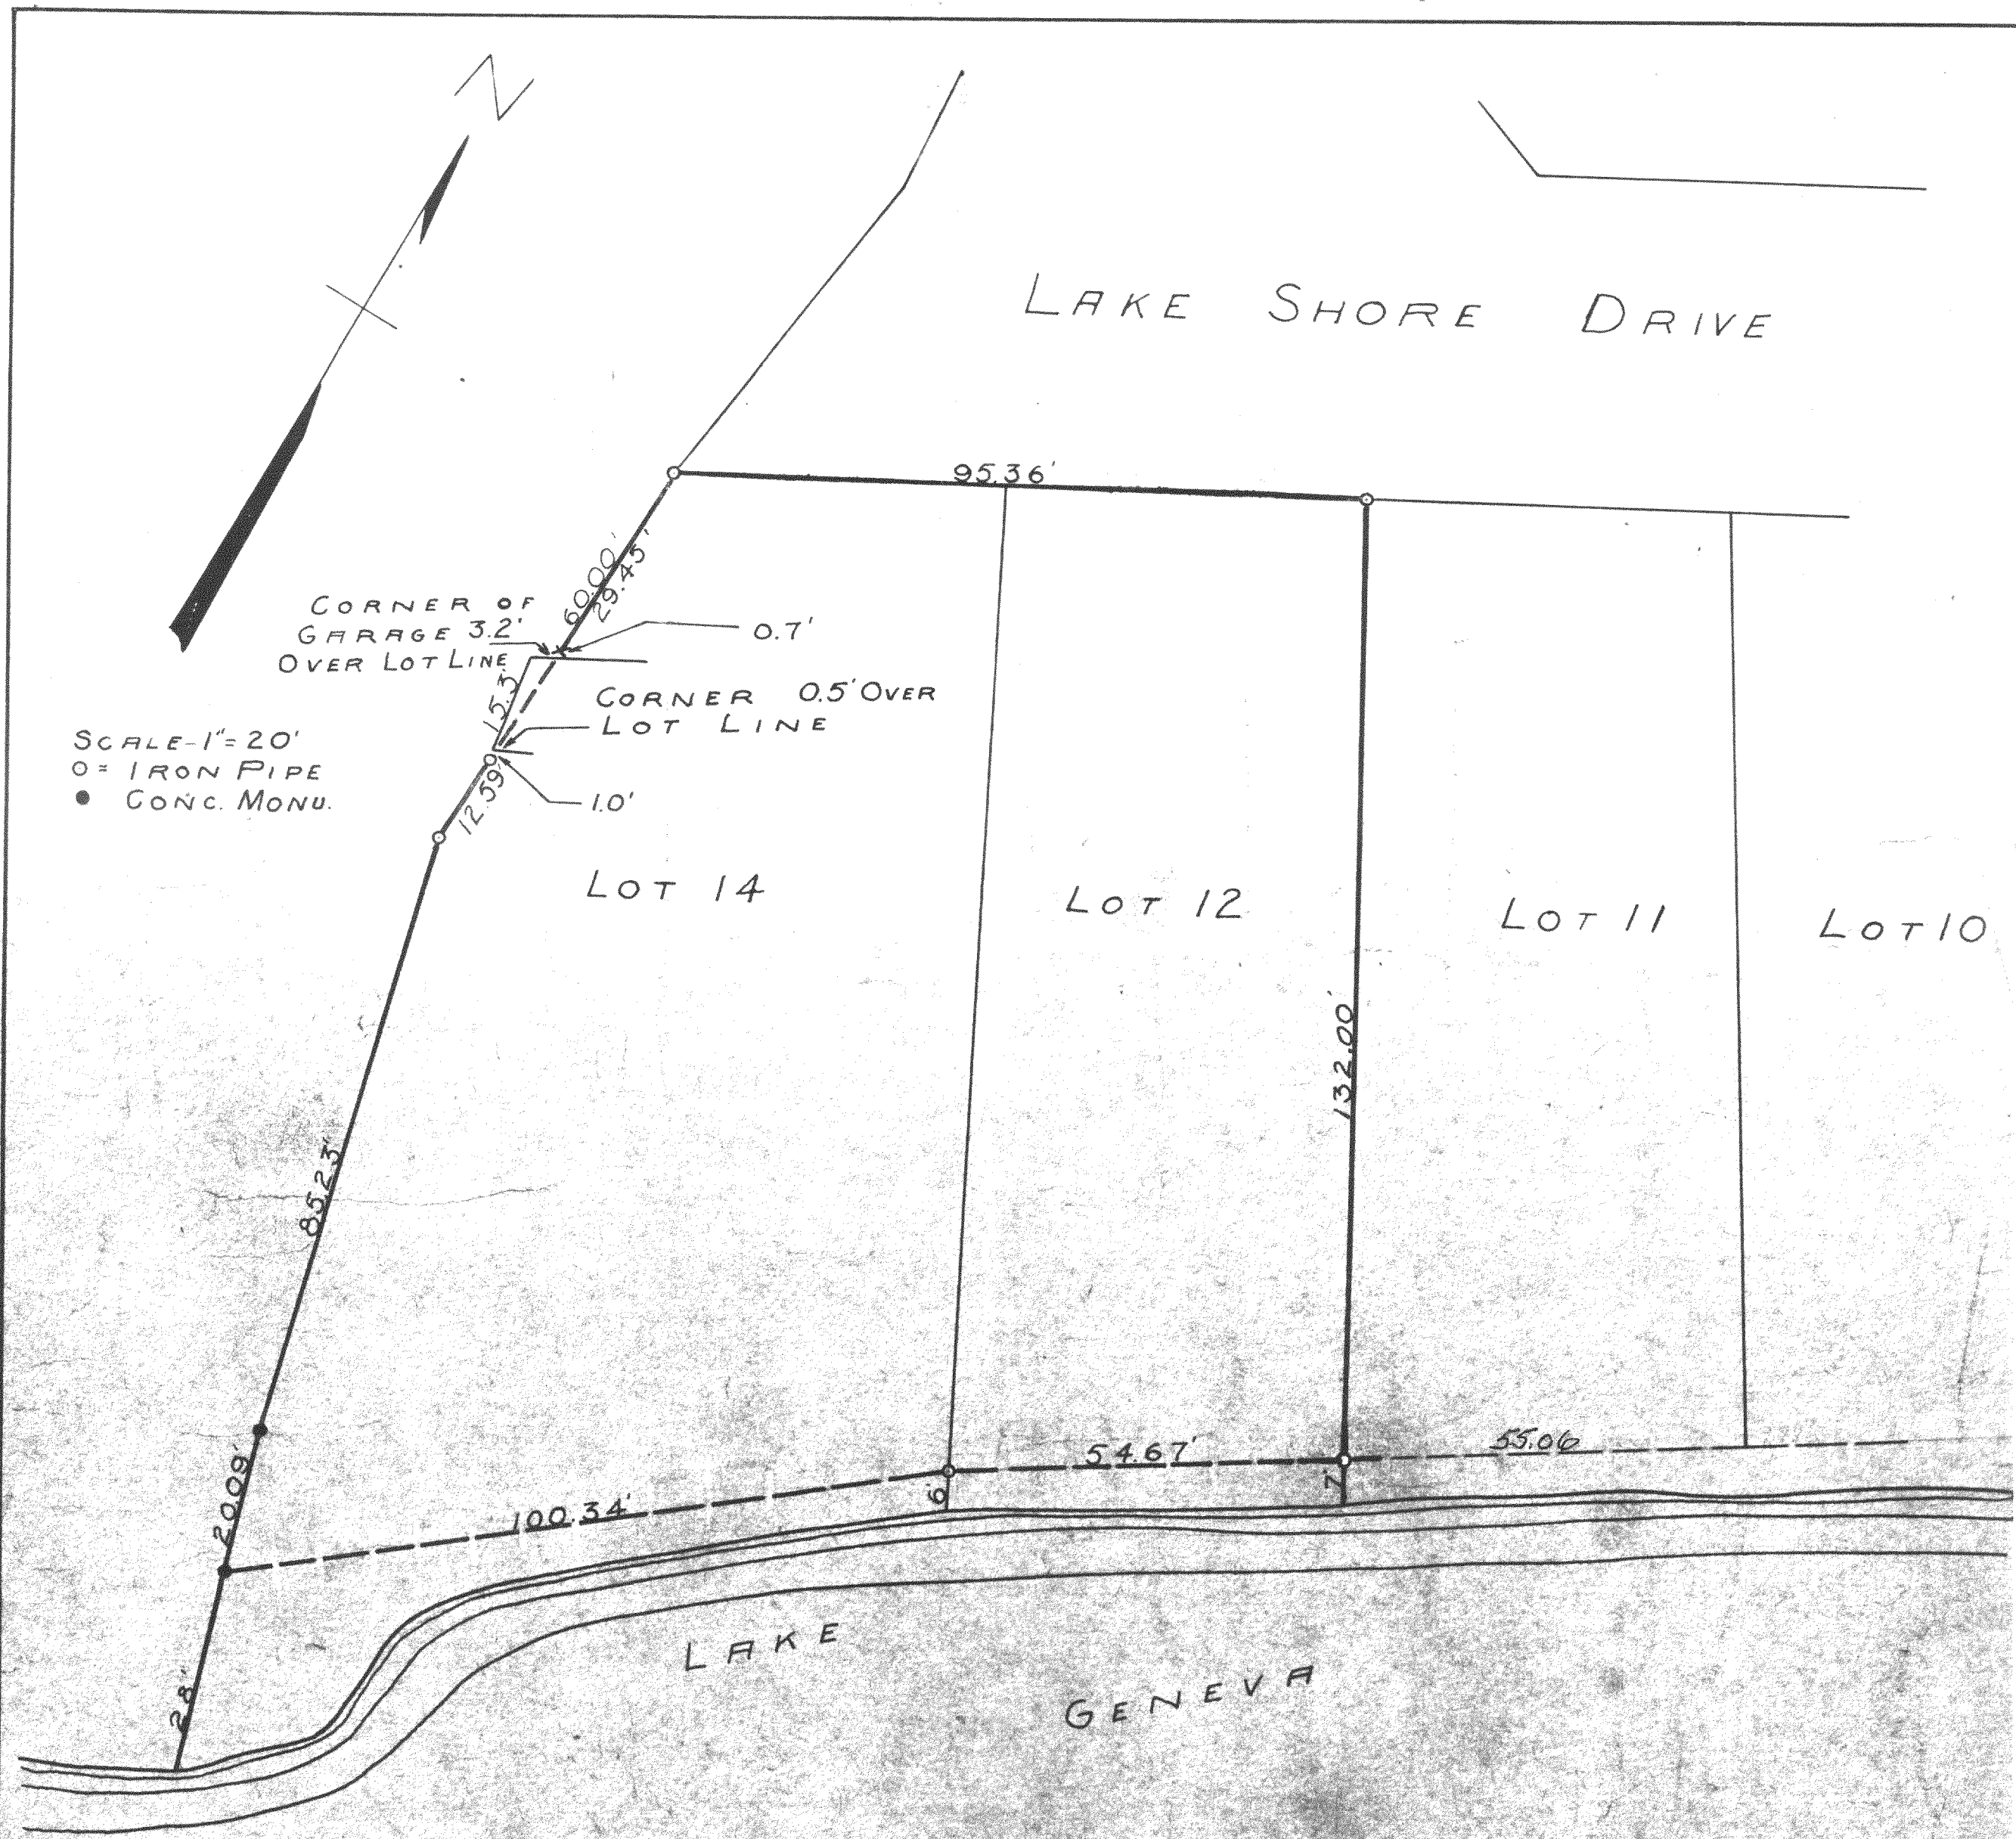

SCALE-1"=20'
O = IRON PIPE
• CONC. MONU.

CORNER OF
GARAGE 3.2'
OVER LOT LINE

CORNER 0.5' OVER
LOT LINE

LOT 14

LOT 12

LOT 11

LOT 10

LAKE

GENEVA

PLAT OF SURVEY OF LOTS 12 AND 14 OF
BLOCK 18 LAKE GENEVA MANOR LOCATED
IN THE CITY OF LAKE GENEVA WALWORTH
COUNTY WISCONSIN

LM-45 + LM-44

NOV 1947

Lloyd L. Jensen
COUNTY SURVEYOR

7-9J