


WALWORTH COUNTY
 SURVEYING & MAPPING
 727 HENRY STREET
 LAKE GENEVA, WISCONSIN
 414-248-0505

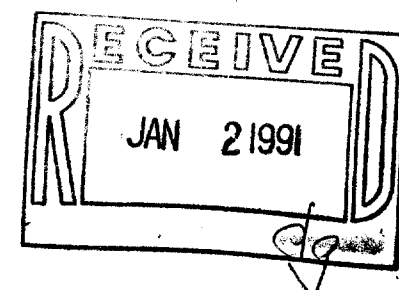

PLAT OF SURVEY OF

A PARCEL OF LAND LOCATED IN THE SW 1/4 OF SECTION 1, T 1 N, R 17 E, WALWORTH COUNTY, WISCONSIN BOUNDED AND DESCRIBED AS FOLLOWS: BEGINNING AT THE NORTHERLY CORNER OF LOT 5 OF CEYLON COURT ESTATES, A SUBDIVISION LOCATED IN SAID SECTION 1 AND RUN THENCE S46°26'W ALONG THE NORTH LINE OF LOT 5 OF SAID SUBDIVISION 250.70 FEET TO THE SHORE OF GENEVA LAKE; THENCE N53°02'W ALONG SAID SHORE 46.57 FEET; THENCE N42°59'W ALONG SAID SHORE 61.34 FEET; THENCE S82°35'E 62.68 FEET; THENCE S47°33'E 36.06'; THENCE S9°47'E 47.84 FEET TO THE PLACE OF BEGINNING.

ORDERED BY: KEEFE REAL ESTATE
 704 MAIN STREET
 LAKE GENEVA, WISCONSIN
 53147


I HEREBY CERTIFY THAT I HAVE SURVEYED THE ABOVE DESCRIBED PROPERTY AND THAT THE ABOVE MAP IS A TRUE REPRESENTATION THEREOF AND SHOWS THE SIZE AND LOCATION OF THE PROPERTY, ITS EXTERIOR BOUNDARIES, THE LOCATION OF ALL VISIBLE STRUCTURES AND DIMENSIONS OF ALL PRINCIPAL BUILDINGS THEREON, BOUNDARY FENCES, APPARENT EASEMENTS, ROADWAYS AND VISIBLE ENCROACHMENTS, IF ANY, TO THE BEST OF MY KNOWLEDGE AND BELIEF.

THIS SURVEY IS MADE FOR THE USE OF THE PRESENT OWNERS OF THE PROPERTY AND ALSO THOSE WHO PURCHASE, MORTGAGE OR GUARANTEE THE TITLE THERETO WITHIN ONE (1) YEAR FROM DATE HEREOF.

Robert M. Baerenwald
 ROBERT M. BAERENWALD
 WISCONSIN REGISTERED LAND SURVEYOR, S-1508

DATE Aug. 3, 1990
 JOB NO. 2808

NOTE: THIS IS NOT A CERTIFIED COPY UNLESS SEALED.

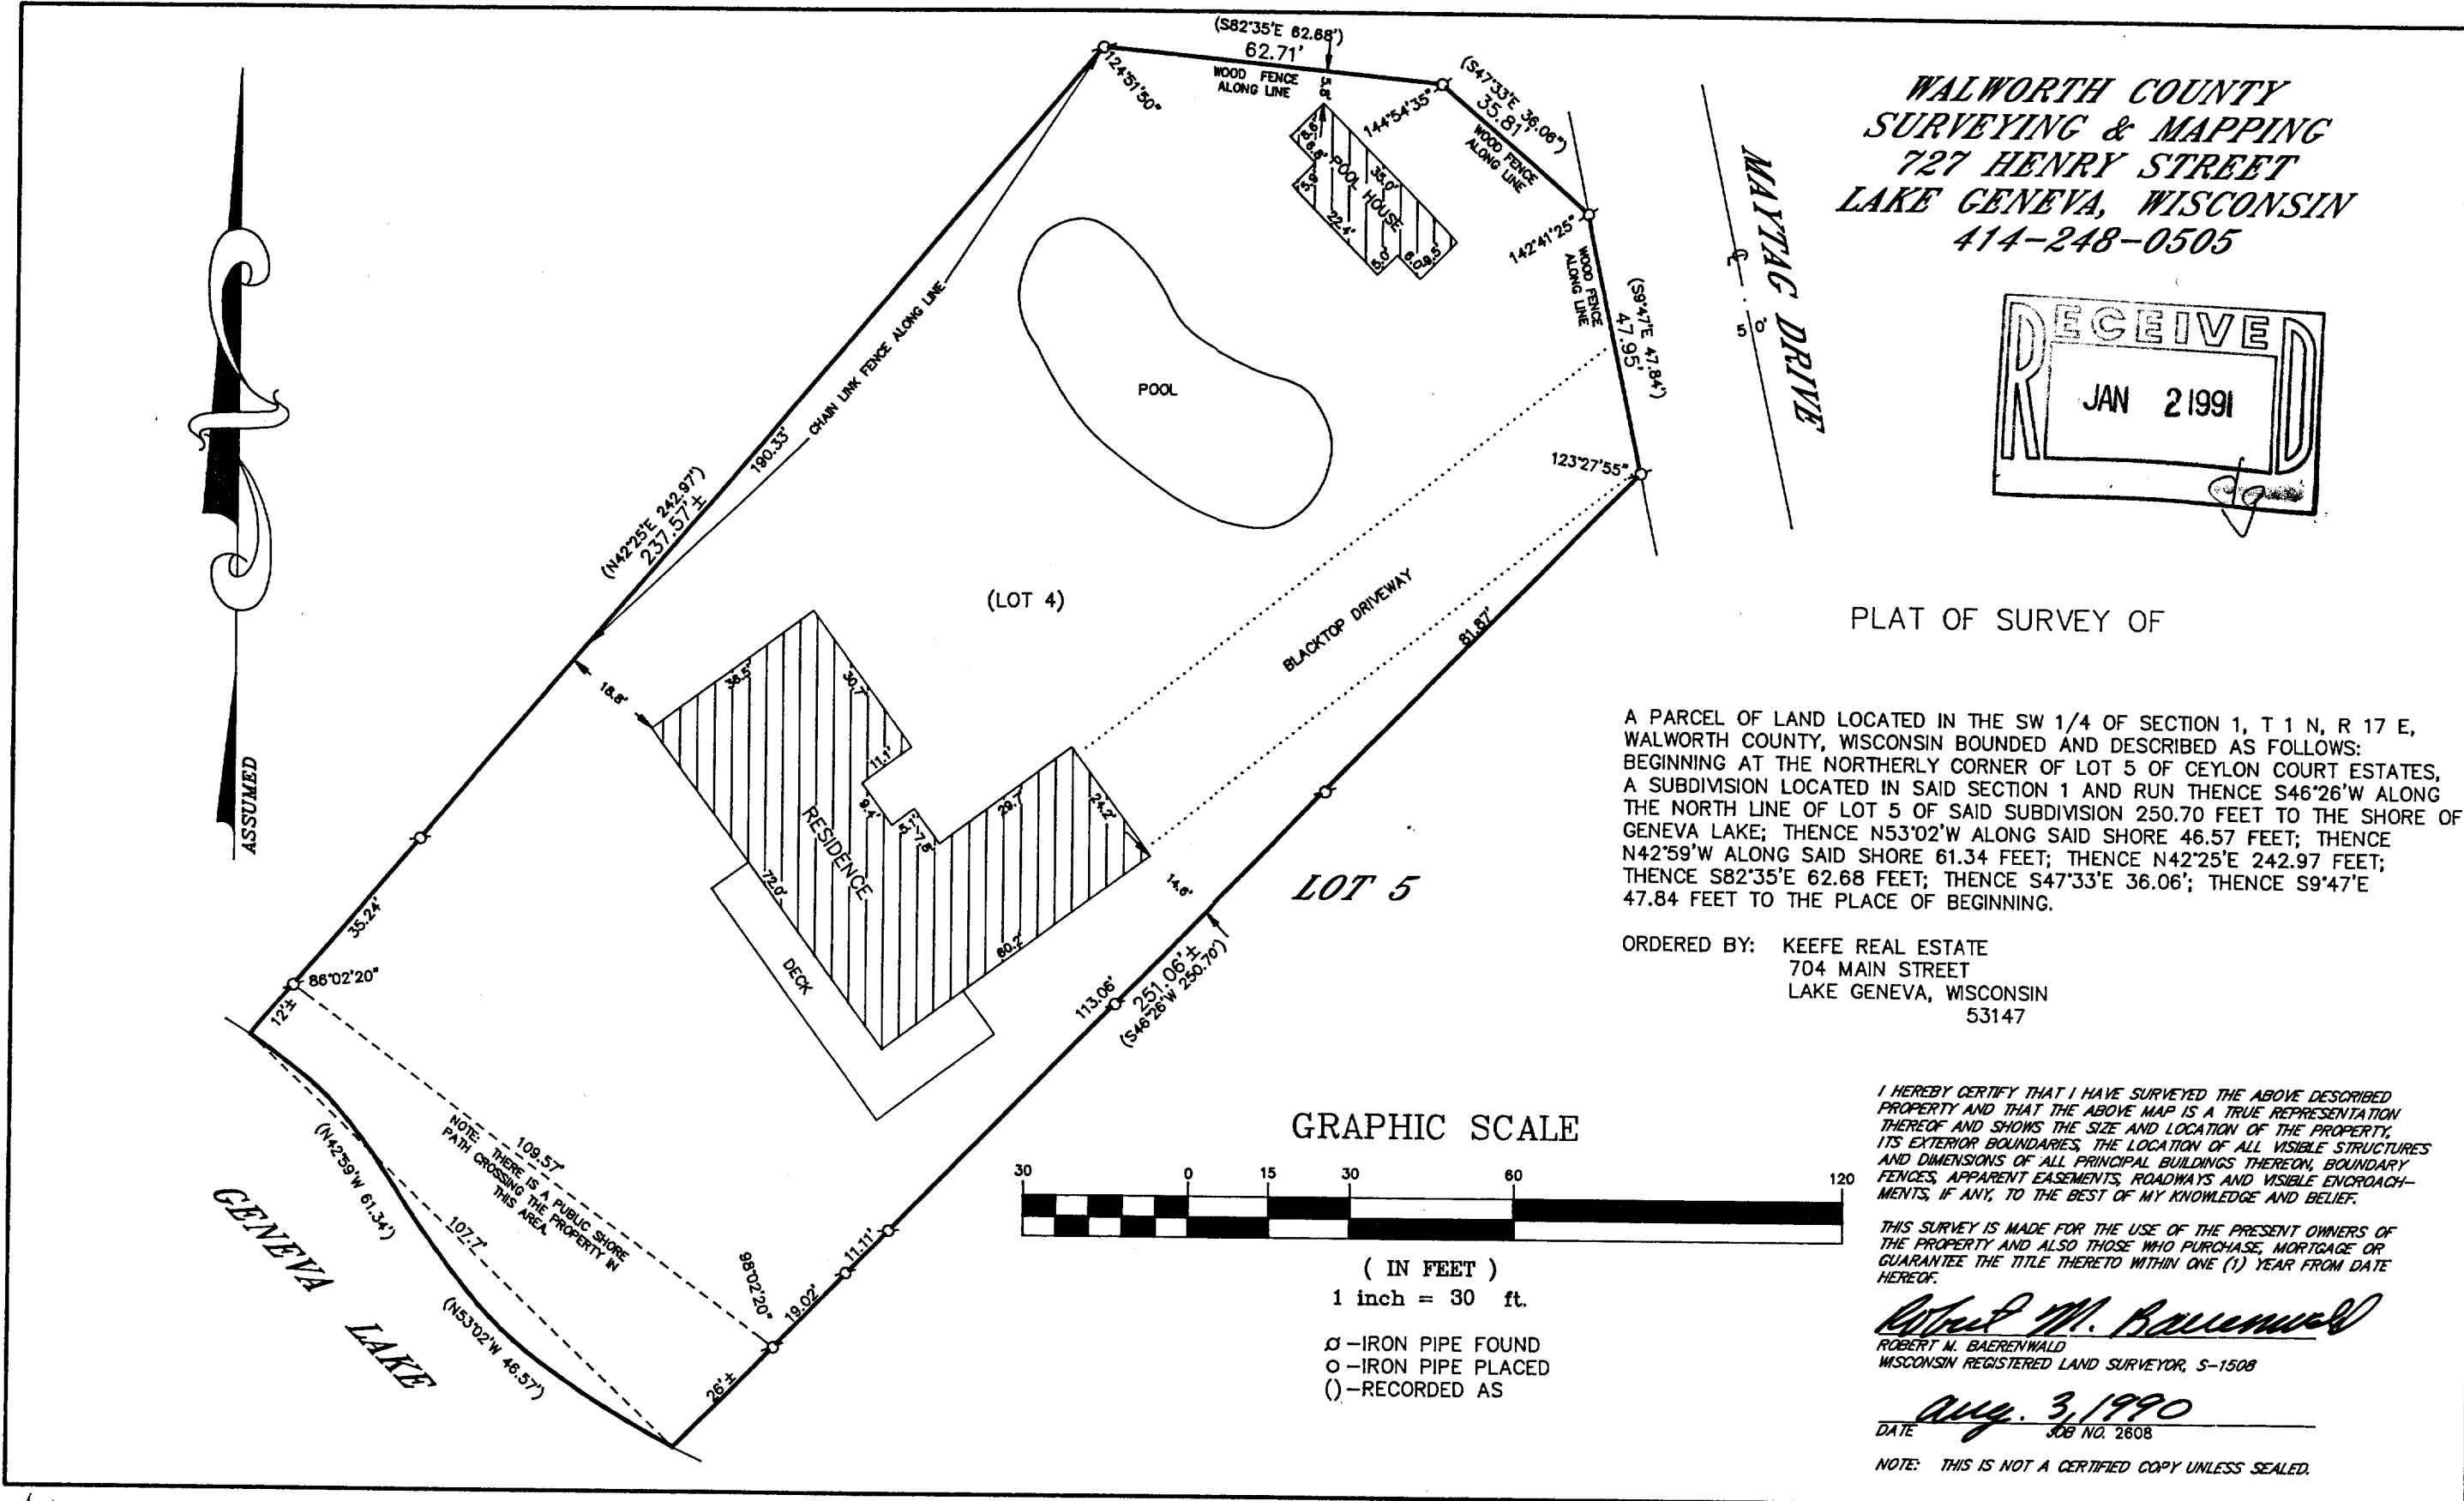

007-1231

Z40P 00141A