




TOPOGRAPHIC SURVEY

Part of the Northwest Quarter of Section 1, Township 1, Range 17, East
 of the Fourth Principal Meridian, in Walworth County, Wisconsin.

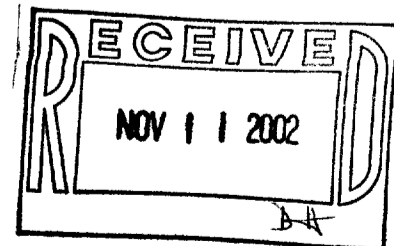

CLIENT: MIDWEST ARBOR CORPORATION
 DRAWN BY: ST CHK'D BY: WJV
 SCALE: 1"=20' SEC. 1 T. 1 R. 17 E.
 P.I.N.: LINN TWP.-WALWORTH COUNTY
 JOB NO.: 000582 I.D. TP. BK. PG.
 ALL DISTANCES SHOWN IN FEET AND DECIMAL PARTS THEREOF
 CORRECTED TO 68° F.

PROJECT BENCHMARK
 6" 9" 36" CONCRETE COUNTY MONUMENT @ CENTER
 OF SECTION 1-1-17. ELEVATION=927.51'
 * - DENOTES 5/8" IRON BAR SET @ PROPERTY LINE.

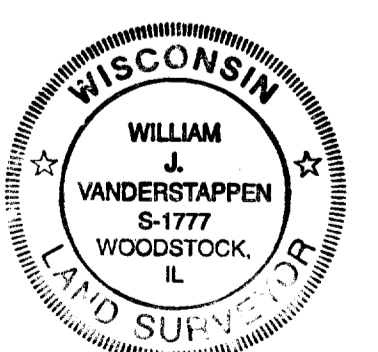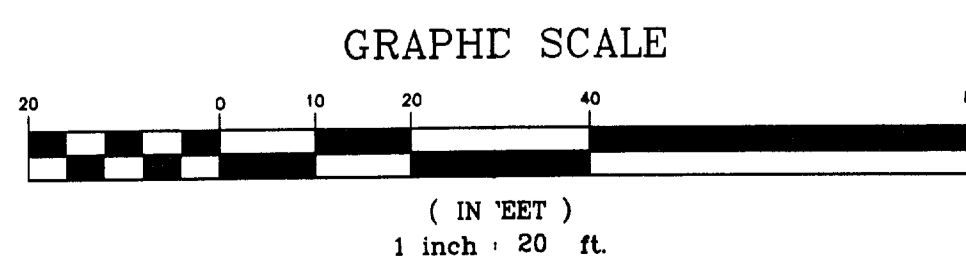

STATE OF ILLINOIS)
) S.S.
 COUNTY OF McHENRY)
 We, Vanderstappen Surveying, Inc. do hereby state that we have caused the
 above described property to be topographically surveyed and that the plat
 hereon drawn is a correct representation of said topography.
 Dated this 25th day of JULY, A.D., 2000
 VANDERSTAPPEN SURVEYING, INC.
 William A. Vanderstappen
 Wisconsin Registered Land Surveyor, No. 1777-008