

PART OF THE NE 1/4, NW 1/4, & SW 1/4 OF SECTION 12, TOWN 1 NORTH,
RANGE 17 EAST, CITY OF LAKE GENEVA, WALWORTH COUNTY, WISCONSIN




ZYOD-181

CITY OF LAKE GENEVA, WALWORTH COUNTY, WISCONSIN

RIDGEWAY COURT P.O. BOX 437

007-2577

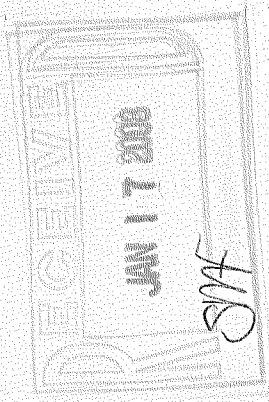

DISCUSSION

IL 1200015

ALTA SURVEY
SURVEYOR'S CERTIFICATION
This survey is made for the
Chicago Title Insurance Company
Hummel Geneva Ridge Partners
Mirbeau of Geneva Lake LLC

I, Peter S. Gordon, Professional Land Surveyor do hereby certify to the aforesaid parties, that I have made a careful survey of a tract of land described as attached:

1.) This is to certify that this map as plat and the survey on which it is based were made in accordance with Mining Statutes and the requirements for ALTA/ACSM Land Title Surveys as established and adopted by the ALTA/NSPS 2005 Standard, 3rd Edition, 2005, and 11(a), 11(b), 16, AND 17 of Table A thereof. Pursuant to the accuracy standards set forth in ALTA/NSPS and in effect on the date of this certification, undersigned further certifies that as a professional opinion, as a land surveyor registered in the State of Wisconsin, the Relative Positional Accuracy of this survey does not exceed that which is specified therein.

Note: Prior to the transfer of title to the above described parcel all requirements of the

2.b). The accompanying survey was made on the ground and correctly shows the location of all buildings, structures, and other improvements situated on the above premises; there are no visible encroachments on the subject property or upon adjacent land abutting said property except as shown hereon and was made in accordance with laws and/or Minimum Standards of the State of Wisconsin.

3.c) Upon receipt of this survey will be revised to reflect the following ALTA standards. The Company has been advised by the title insurance industry that the current standard form of the Surveyors' Title Commitment No. 423-740, dated January 2, 2008 and amended January 15, 2008 that all easements, covenants and restrictions referenced to it said title commitment or apparent from a physical inspection of the subject site have been removed. It is well known to me that been plotted hereon or otherwise noted on its effect on the subject site.

Dated January 10, 2008
Revised January 16, 2008

Peter S. Gordon
Registration No: 2191

