


Plat of Survey



See Legal Description on Sheet 1

Surveyed for: Ernie Bayer
26161 Via Marejada
Mission Viejo, California. 92691

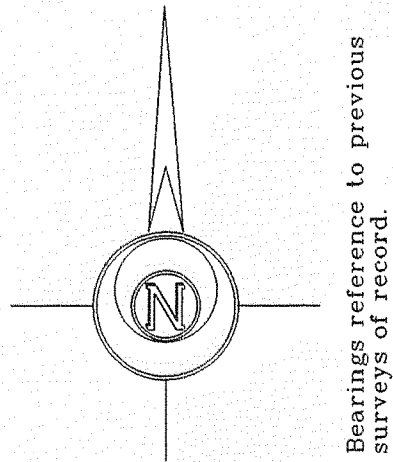

North 1/4 Corner
Section 1-1-17.
N. 216,265.28
E. 2,421,933.92

Geneva
Lake

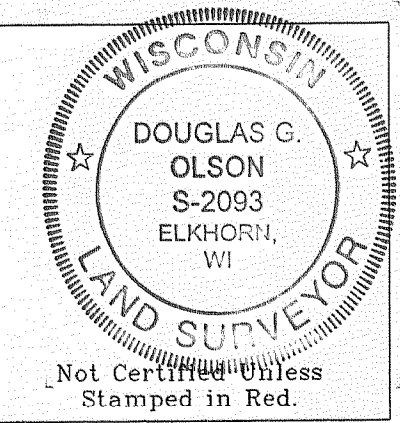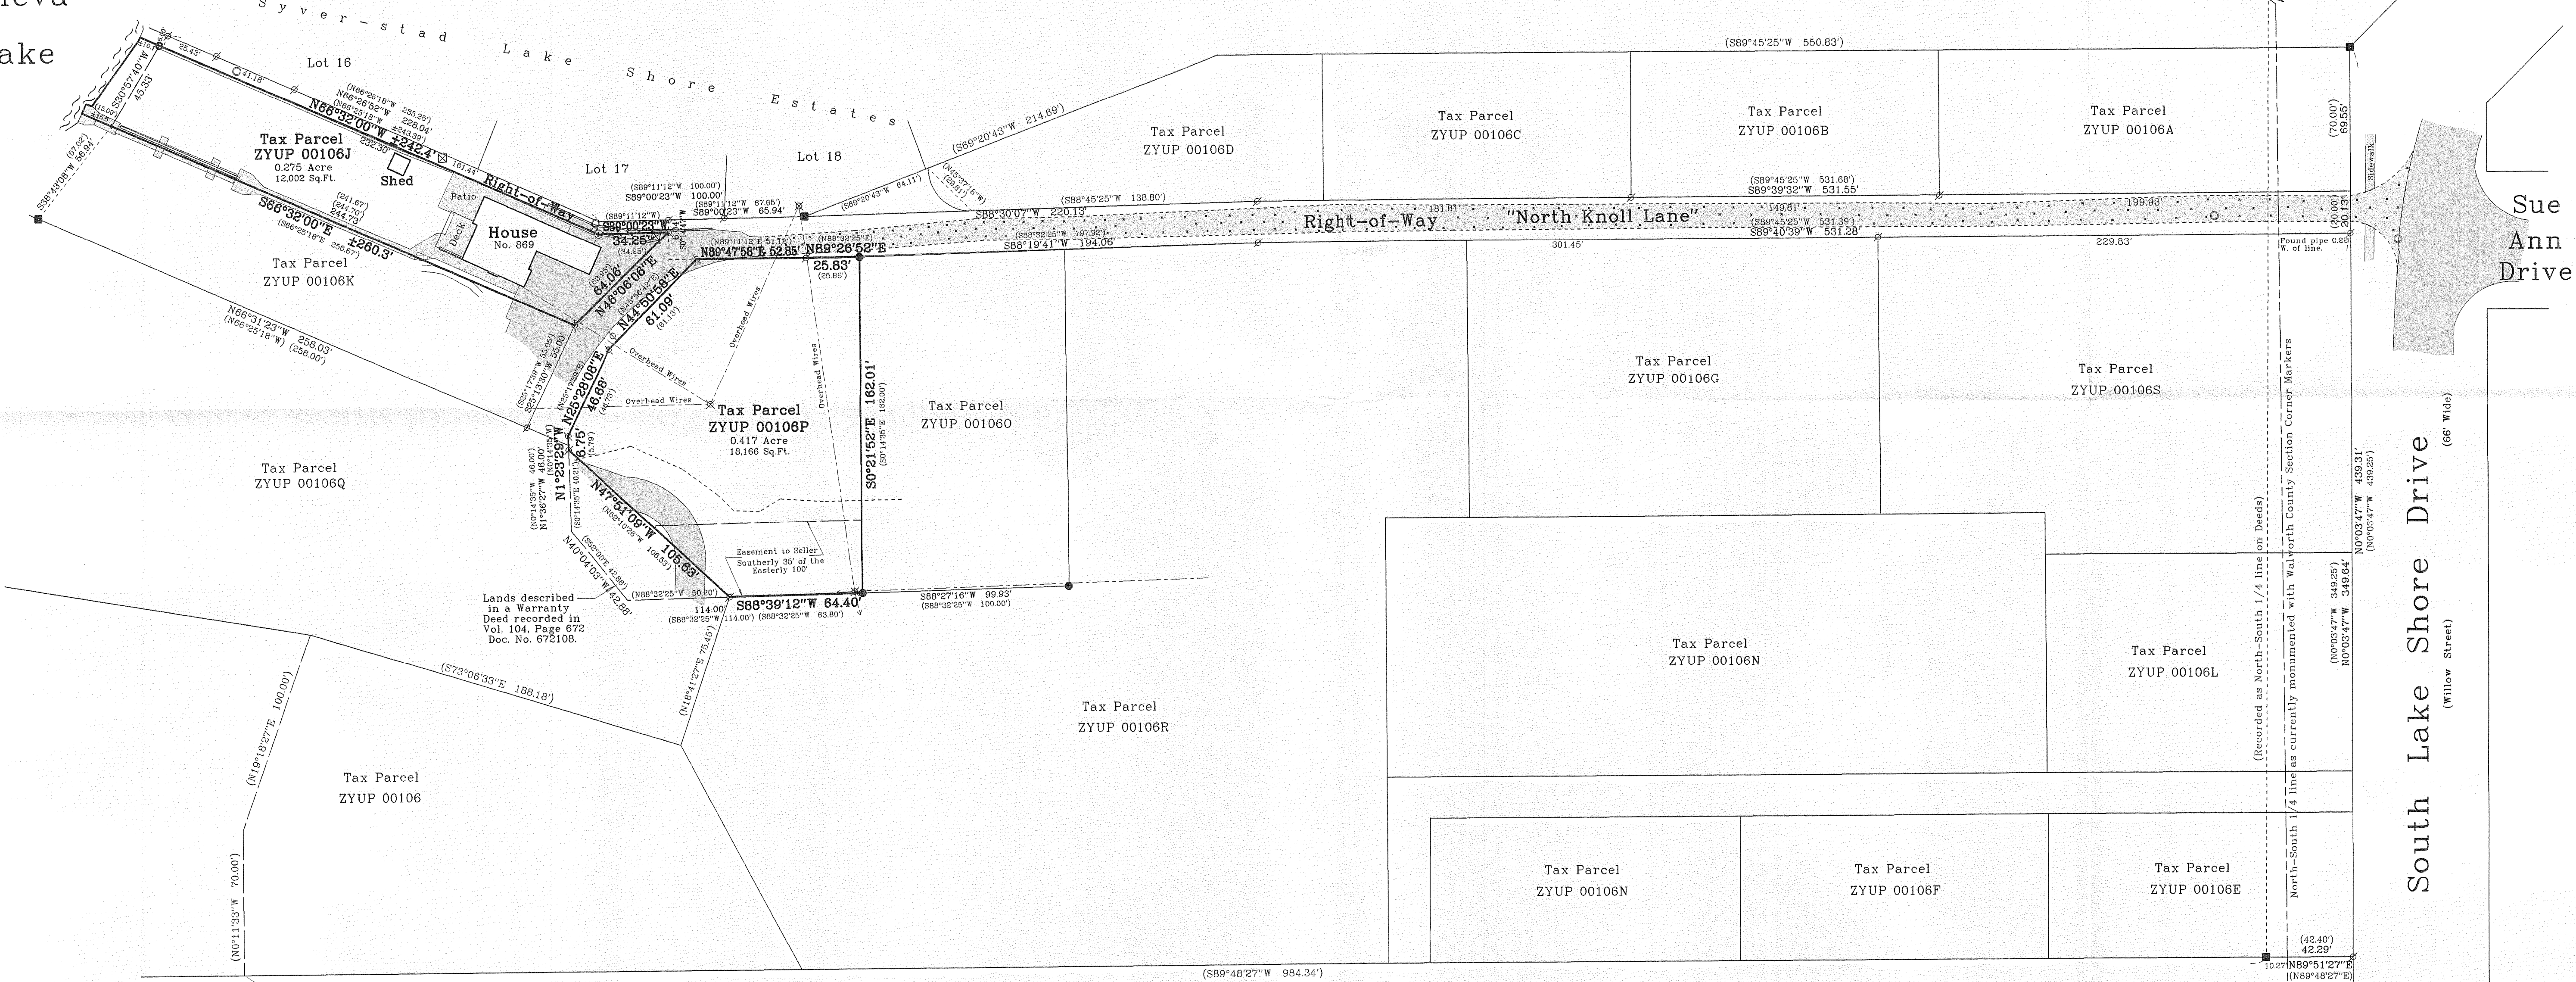

Notes: 1) This survey plat is not certified unless signed and sealed in red ink.
2) This survey is subject to Wisconsin lien laws. This Plat of Survey is the notice of intent to file lien. Lien waiver required.

Copyright © 2007 by Jensen & Olson Land Surveying, LLC.
All rights reserved. No part of this survey plat may be reproduced or transmitted in any form by any means - graphic, electronic, or mechanical, including photocopying, tracing, or information storage and retrieval systems - without permission in writing from Douglas G. Olson, Jensen & Olson Land Surveying, LLC.


I, Douglas G. Olson, Wisconsin Registered Land Surveyor, do hereby certify that this survey was performed by me or under my direction in full compliance with the owner's/agent's instructions and Chapter A-E 7 of the Wisconsin Administrative Code "Minimum Standards for Property Survey", and that this map is an accurate representation thereof to the best of my knowledge and belief.

Douglas G. Olson
Wisconsin Registered Land Surveyor - 2093


Center 1/4 Corner
Section 1-1-17.
N. 213,363.49
E. 2,422,000.90

Survey date: November 6, 2007.
Revisions:

Scale in Feet
1" = 40'

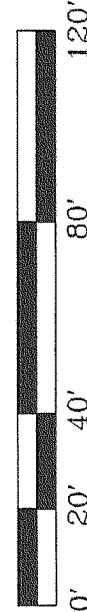

Jensen & Olson Land Surveying, LLC

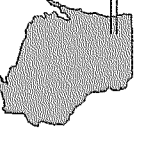

45 South Wisconsin Street P.O. Box 322
Elkhorn, Wisconsin. 53121
Telephone: (262) 723-3434
Facsimile: (262) 723-8044

Legend

- Found County Section Corner
- Found Concrete or Stone Monument
- Found Iron Pipe Cross
- Found Iron Rod
- Set Chiselled Cross
- Set Iron Rod, 3/4" dia.
- Set Iron Rod, 1/2" dia.
- Utility Pole
- Manhole
- Asphalt Surface
- Gravel Surface
- Concrete Surface
- Brick Surface

Sheet 2 of 2 Sheets.

Job Reference Number

2007.136

2007.136