


Plat of Survey


See Legal Description on Sheet 1

Surveyed for: **Ernie Bayer**
26161 Via Marejada
Mission Viejo, California. 92691

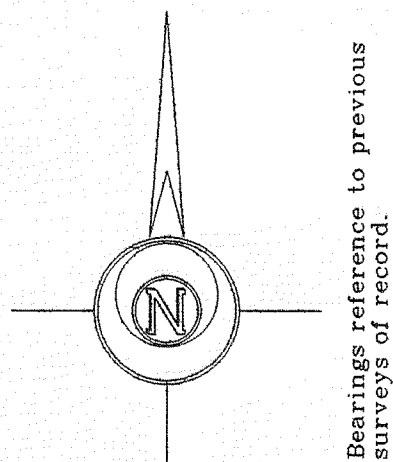


North 1/4 Corner
Section 1-1-17.
N. 216,265.28
E. 2,421,933.92

Geneva
Lake

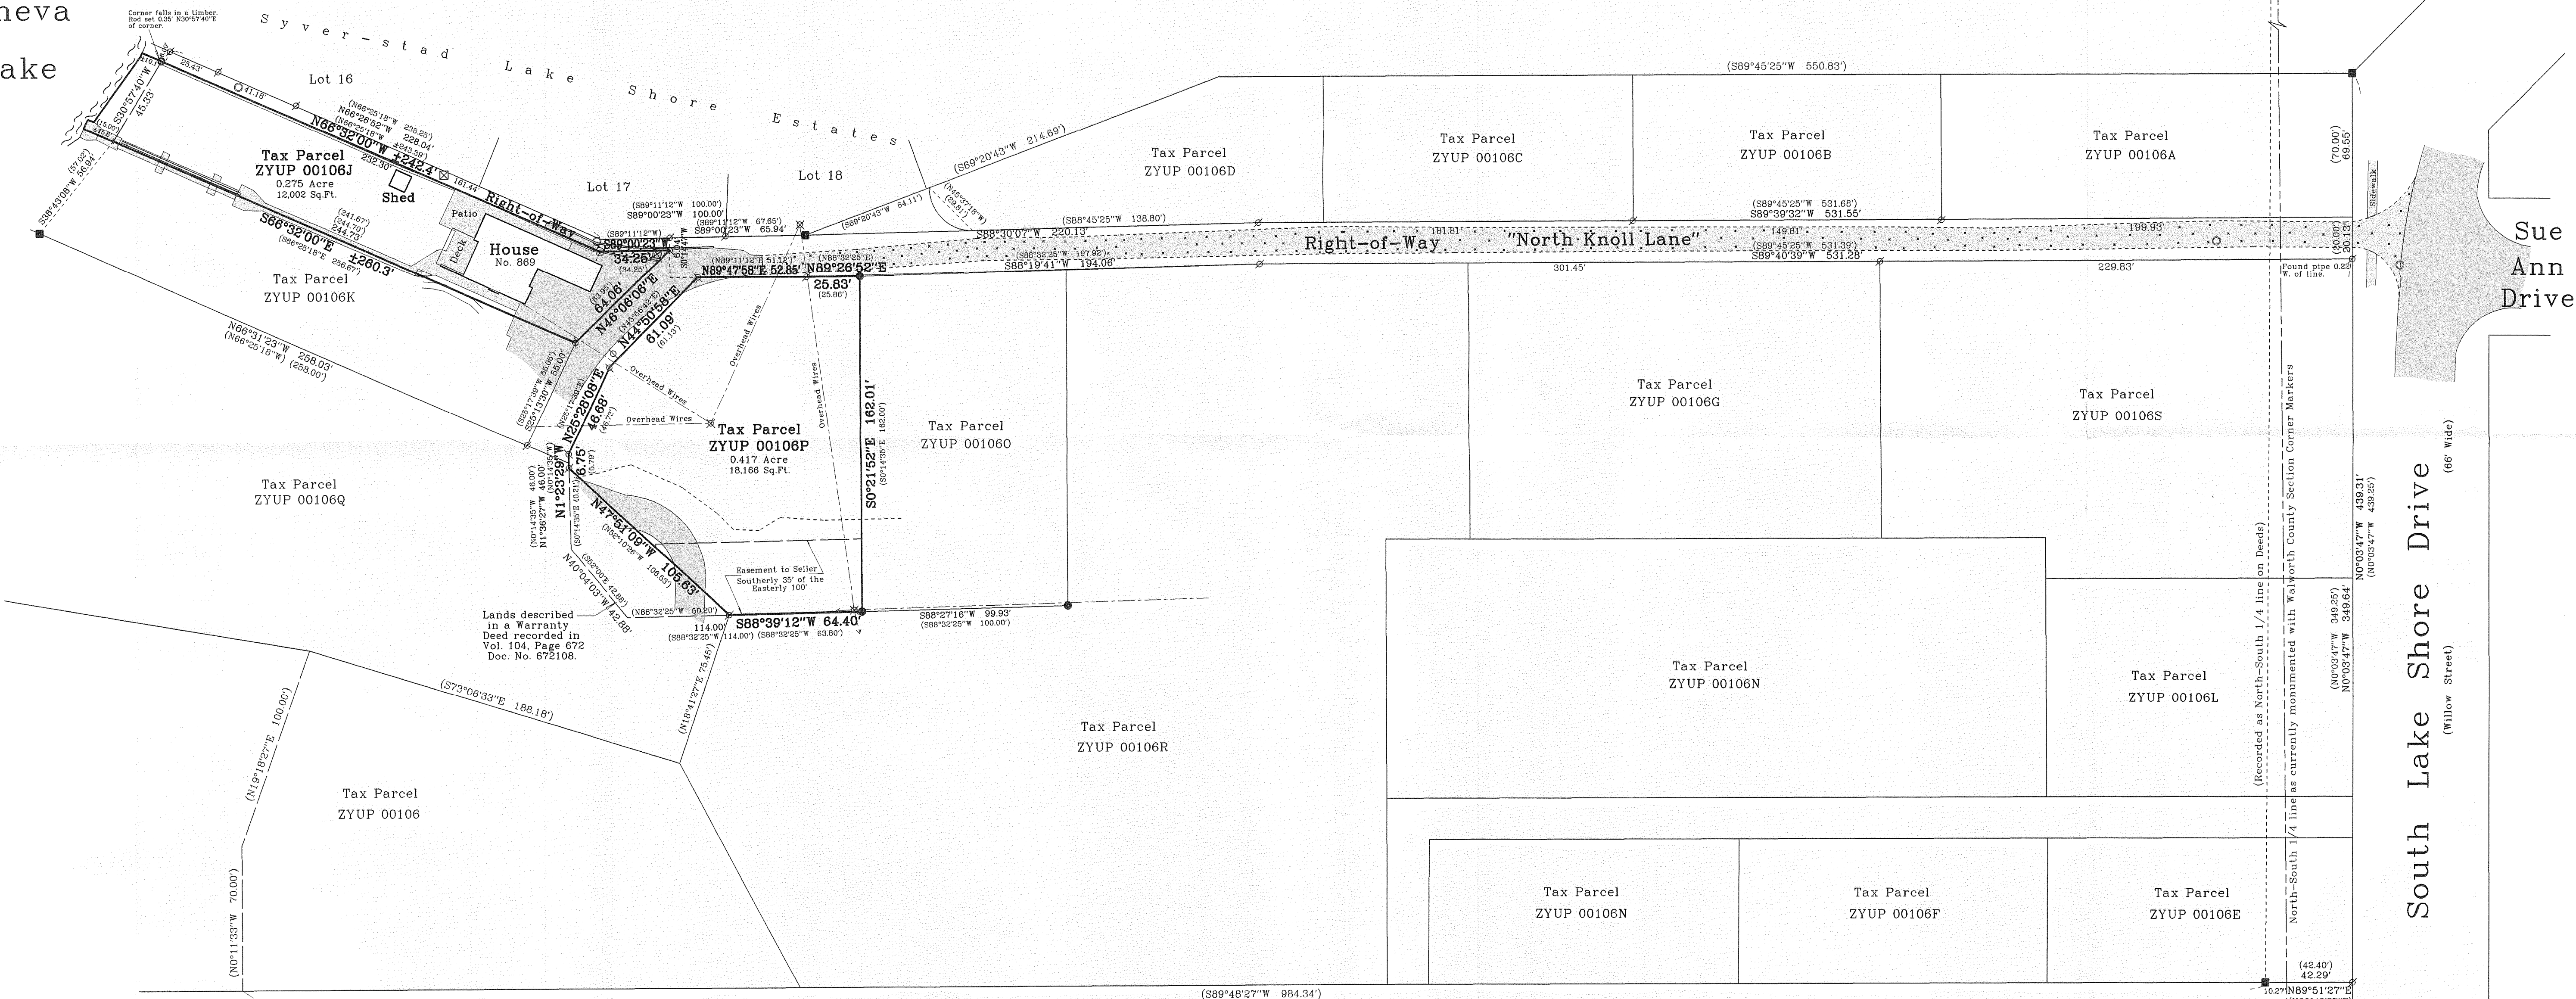

Lands described
in a Warranty
Deed recorded in
Vol. 104, Page 672
Doc. No. 672108.

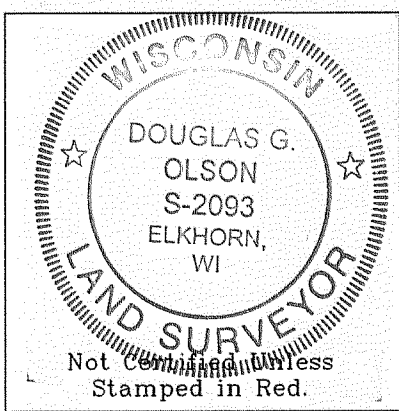

Notes: 1) This survey plat is not
certified unless signed
and sealed in red ink.
2) This survey is subject to Wisconsin lien laws.
This Plat of Survey is the notice of intent
to file lien. Lien waiver required.

Copyright © 2007 by Jensen & Olson Land Surveying, LLC.
All rights reserved. No part of this survey plat may be reproduced
or transmitted in any form by any means - graphic, electronic, or
mechanical, including photocopying, tracing, or information storage
and retrieval systems - without permission in writing from Douglas
G. Olson, Jensen & Olson Land Surveying, LLC.

I, Douglas G. Olson, Wisconsin Registered Land Surveyor,
do hereby certify that this survey was performed by me or under my
direction in full compliance with the owner's/agent's instructions
and Chapter A-E 7 of the Wisconsin Administrative Code "Minimum
Standards for Property Surveys," and that this map is an accurate
representation thereof to the best of my knowledge and belief.

Douglas G. Olson
Wisconsin Registered Land Surveyor - 2093

Center 1/4 Corner
Section 1-1-17.
N. 213,363.48
E. 2,422,000.90

Survey date: November 6, 2007.
Revisions: No. 1 - Set Rod

Scale in Feet
1" = 40'
0' 20' 40' 80' 120'

Jensen & Olson Land Surveying, LLC
45 South Wisconsin Street P.O. Box 322
Elkhorn, Wisconsin. 53121
Telephone: (262) 723-3434
Facsimile: (262) 723-8044

Legend
Found County Section Corner
Found Concrete or Stone Monument
Found Chiseled Cross
Set Chiseled Cross
Recorded Information
Utility Pole
Catch Basin
Concrete Surface

Sheet 2 of 2 Sheets.
Job Reference Number
2007.136

2007.136

ZYUP-106 ZYUP 106P

007-2584