FARRIS, HANSEN & ASSOCIATES, INC.

ENGINEERING - ARCHITECTURE - SURVEYING 7 RIDGWAY COURT - P.O. BOX 437 - ELKHORN, WISCONSIN 53121 PHONE: (262) 723-2098 FAX: (262) 723-5886

PLAT OF SURVEY

PART OF THE NW 1/4 SECTION 1 TOWN 1 NORTH, RANGE 17 EAST CITY OF LAKE GENEVA WALWORTH COUNTY, WISCONSIN


3. The land referred to in the Commitment is described as follows:

Lot 3, Lake Geneva East Shore Estates Subdivision located in the Northwest 1/4 of Section 1, T1N, R17E, City of Lake Geneva, Walworth County, Wisconsin.

Tax Key No: ZLE 00003

EXCEPTING THEREFROM

Part of Lot 3 of Lake Geneva East Shore Estates Subdivision, located in Government Lot 2 in the Northwest 1/4 of Section 1, Town 1 North, Range 17 East, City of Lake Geneva, Walworth County, Wisconsin described as follows:

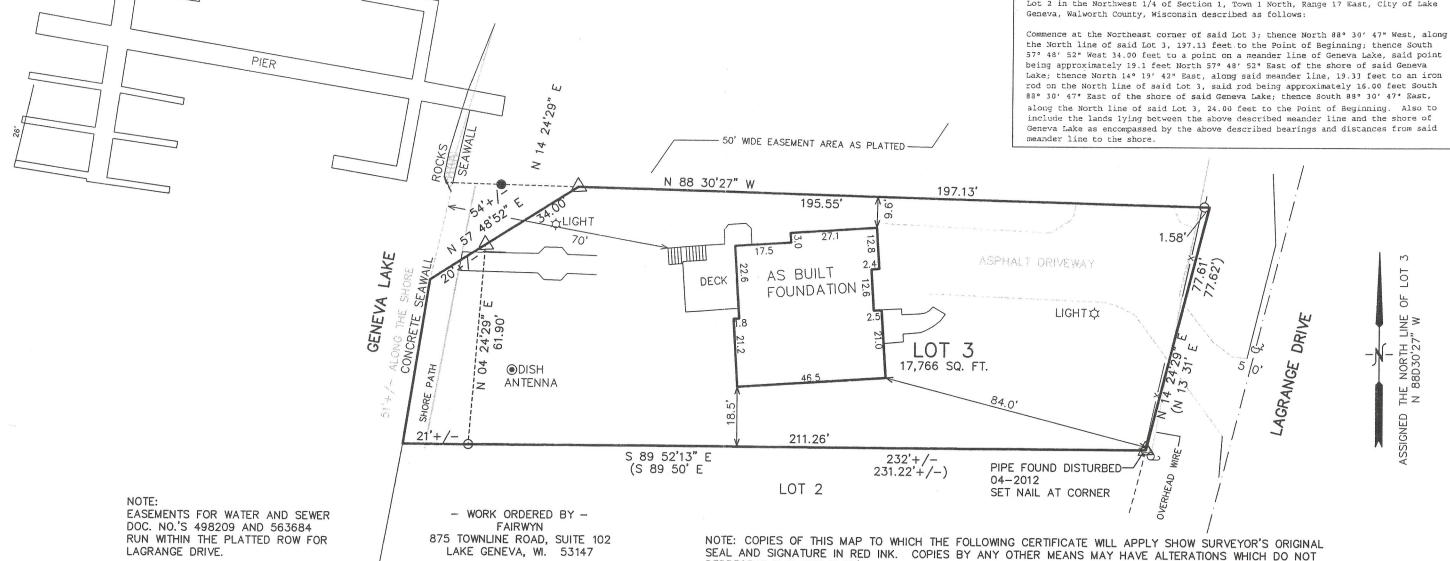

LEGEND

O = FOUND IRON PIPE STAKE

= FOUND IRON REBAR STAKE

(XXX) = RECORDED AS

= SET LANDSCAPE SPIKE

80 70 60

ELKI-ORN MAP SCALE IN FEET ORIGINAL 1" = 30'

SEAL AND SIGNATURE IN RED INK. COPIES BY ANY OTHER MEANS MAY HAVE ALTERATIONS WHICH DO NOT REPRESENT THE SURVEYOR'S WORK PRODUCT.

I HEREBY CERTIFY THAT THE ABOVE DESCRIBED PROPERTY HAS BEEN SURVEYED UNDER MY DIRECTION AND THAT THE ABOVE MAP IS A TRUE REPRESENTATION THEREOF AND SHOWS THE SIZE AND LOCATION OF THE PROPERTY, ITS EXTERIOR BOUNDARIES, THE LOCATION OF ALL VISIBLE STRUCTURES, AND DIMENSIONS OF ALL PRINCIPLE BUILDINGS THEREON, BOUNDARY FENCES, APPARENT EASEMENTS, ROADWAYS, AND VISIBLE ENCROACHMENTS, IF ANY. THIS SURVEY IS MADE FOR THE USE OF THE PRESENT OWNERS OF THE PROPERTY, AND ALSO THOSE WHO PURCHASE, MORTGAGE, OR GUARANTEE THE TITLE THERETO WITHIN ONE YEAR FROM THE DATE HEREOF.

OCTOBER 13, 2010

PETER S. GORDON R.L.S. 2101

REVISED 10-28-2011 TO SHOW PROPOSED RESIDENCE AND DECK

REVISED 12-22-2011 TO SHOW SIZE & LOCATION OF FOUNDATION AS BUILT

REVISED 04-27-2012 UPDATE BOUNDARY & DETAILS

PROJECT: 8253 DATE: 11-13-2010 SHEET 1 OF 1