

South Lake Shore Drive
(66' Wide)

Plat of Survey

of
Lot 1 of SYVER-stad Lake Shore Estates,
a subdivision located in the Northeast 1/4 of Section 1, Town 1 North,
Range 17 East, City of Lake Geneva, Walworth County, Wisconsin.

Surveyed for: **George & Mary Antonopoulos**
1006 Hillside Road
Northbrook, Illinois. 60062


Copyright 2015 by Olson Land Surveying, LLC.

All rights reserved. No part of this survey plat may be reproduced or transmitted in any form by any means - graphic, electronic, or mechanical, including photocopying, tracing, or information storage and retrieval systems - without permission in writing from Douglas G. Olson, Olson Land Surveying, LLC.



I hereby certify that I have surveyed the above described property and the map hereon is correct to the best of my professional knowledge and belief and shows the size and location of the property, its exterior boundaries, the location and dimensions of all visible structures thereon, boundary fences, apparent easements and roadways and visible encroachments, if any.

This survey is made for the exclusive use of the present owners of the property, and also those who purchase, mortgage or guarantee title thereto, within one year from the date hereof.

Douglas G. Olson
Wisconsin Professional Land Surveyor - 2093

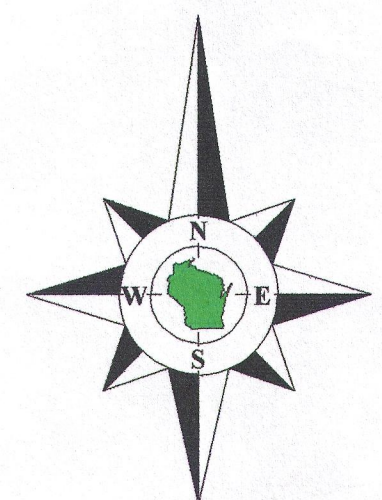

Bearings reference to the plat of
SYVER-stad Lake Shore Estates.

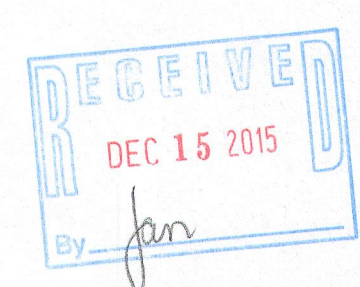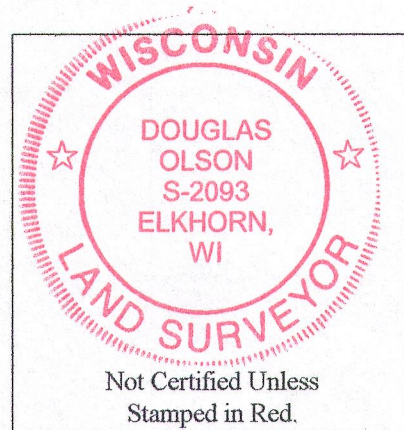

- Notes:**
- 1) This survey plat is not certified unless signed and sealed in red ink.
 - 2) This survey is subject to Wisconsin lien laws. This Plat of Survey is the notice of intent to file lien. Lien waiver required.

Survey Date: July 27, 2015.
Revisions:

Scale in Feet
1" = 20'
0' 10' 20' 40'

Olson Land Surveying, LLC

45 South Wisconsin Street * P.O. Box 322 * Elkhorn, Wisconsin. 53121
Telephone: (262) 723-3434 * Facsimile: (262) 723-8044
Email: doug@olsonsurveying.com

Legend

- Found Concrete Monument
- Found Iron Pipe, 1" dia.
- Set Iron Pipe, 1" dia.
- Recorded Information
- Utility Pole
- Manhole
- Asphalt Surface
- Brick Pavers
- Pedestal
- Lamp
- Concrete

Sheet 1 of 1 Sheets

Drawing Name:

Job Reference Number
2015.058

2015.058

ZSY-1 007-3209