


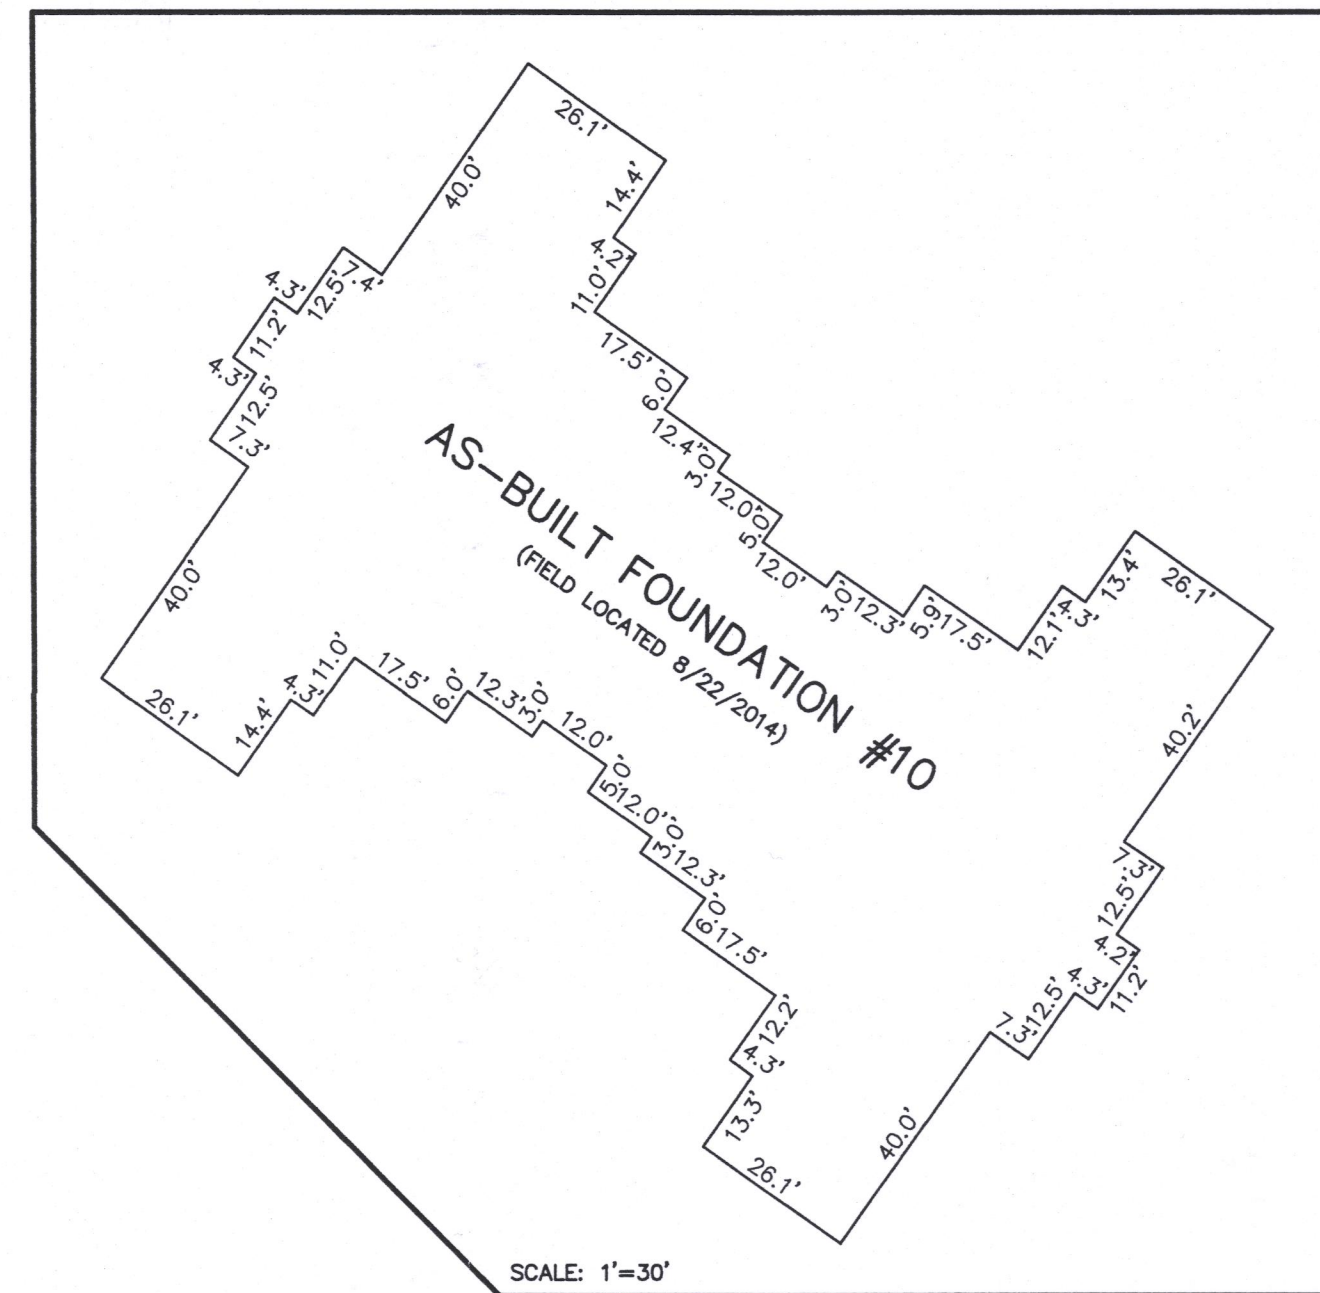

AS-BUILT BUILDING # 11

SCALE: 1"=30'

RECEIVED
MAY 25 2017
By *Jan*

PROJECT NO.
6269

DATE
04-17-2017

SHEET NO.
1 OF 1