



#72-63

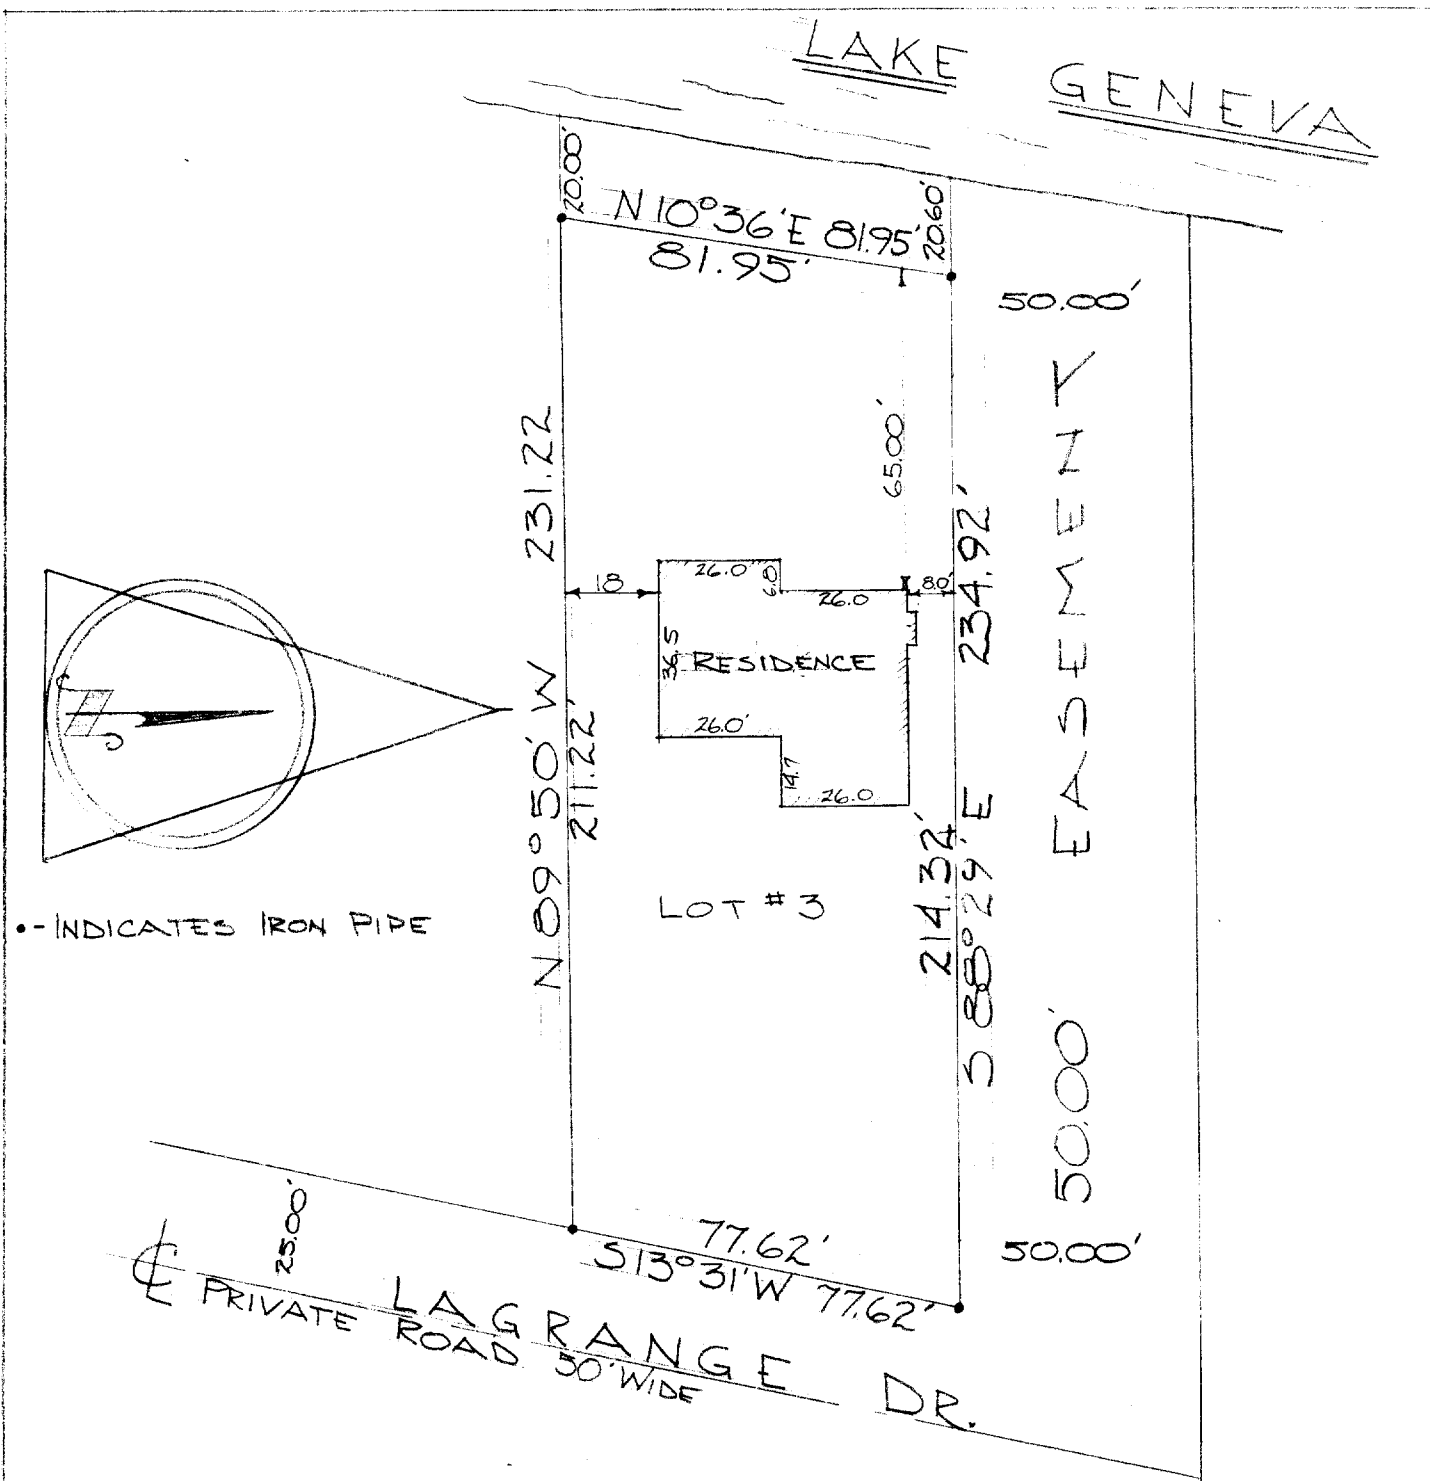

DESCRIPTION: Lot 3 of Lake Geneva East Shore Estates Subdivision located in the City of Lake Geneva, Walworth County, Wisconsin.

CERTIFICATE: I, James F. Biagi, Surveyor, do hereby certify that I have surveyed the property herein described, also that the location of the improvements are as shown.

August 28, 1963

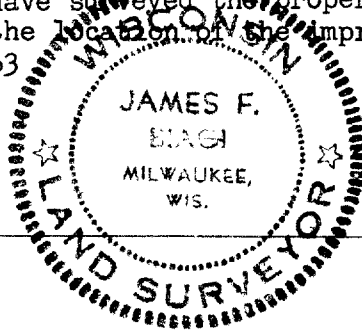

James F. Biagi  
James F. Biagi RLS 272

263

7-47B